


Map No. KANSAS Sec. 15 Twp. 26 R. 2^E

Well No. 3- Lygrisse Farm
Shell Bit Company

_____ Ft. from N. Line
330 Ft. from S. Line
_____ Ft. from E. Line
405 Ft. from W. Line
1930

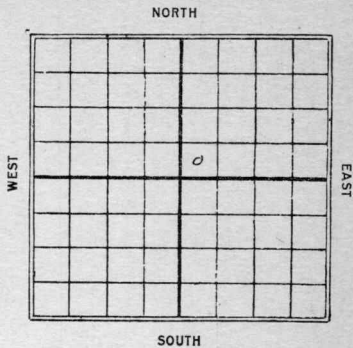

Date	REPORT
10/15	BoS.
10/22	Rgn up
10/29	dry at 325'
11/5	" 1756'
11/12	" 2290'
11/19	Chat 2895 Run 8"-2901
11/25	No report
12/3	T.D. 2901
	Have 1800" fluid in hole
12/10	T.D. 2901
	swab 205 bbl oil
	9/220 bbl water
12/17	Chat 2895-2901
	T.D. 2901
	swab 222 bbl oil
	9/1450 bbl water
	Comp.
1931	OWDD
5/20	Old TD. 2901 Rgn up
5/27	Wdg. 3060' Chat
6/3	Cem 6"-3182'

6/10- Viola 3192-97

T.D. 3197

Pump 1200 bbl.

(Estimated)

Comp.

Sealquich
Map No. **KANSAS** Sec. *15* Twp. *26* R. *25*

Well No. *8 Lyguise*

She W. P. D. Company

Contractor

SECTION PLAT

..... Ft. from N. Line

220 Ft. from S. Line

..... Ft. from E. Line

405 Ft. from W. Line

		0	

FIRST REPORTS


Location.....

Rig up.....

Drilling and Remarks:

ROG

RECORD

Cased..... in., ft.

Sand.....

Gas.....

Oil.....

Total Depth.....

PRODUCTION

1st 24 hrs. Nat.....

1st 24 hrs. after shot.....

Gas..... Cu. Ft.

Dry Hole.....

Abandoned.....

Date

OCT 15 1930

192

S. J. LEWIS Scout

Map No. *12* **KANSAS** Sec. *15* Twp. *26* R. *2E*

Well No. *3 Lyguise*

Shell Rd. Company

Contractor

SECTION PLAT

		0	

..... Ft. from N. Line

330 Ft. from S. Line

..... Ft. from E. Line

405 Ft. from W. Line

COMPLETED

Location.....

Rig up.....

Drilling and Remarks:

*swab 222 yds.
oil 1450 yds water*

RECORD

Cased..... in., ft.

Sand *2895-2901*

Gas.....

Oil.....

Total Depth *2901*

PRODUCTION

1st 24 hrs. Nat.....

1st 24 hrs. after shot.....

Gas..... Cu. Ft.

Dry Hole.....

Abandoned.....

Date

DEC 17 1930

192

S. J. LEWIS

Scout

Seagwick

13 **KANSAS** Sec. *15* Twp. *26* R. *2* ^E

Well No. *3* *Lygisse*

Shell Pet Co Company

Contractor

FIRST REPORTS

SECTION PLAT

..... Ft. from N. Line

330 Ft. from S. Line

..... Ft. from E. Line

405 Ft. from W. Line

		o	

"Dep well Deeper"

RECORD

Location.....

Cased..... in., ft.

Rig up *JD 2901*

Sand.....

Gas.....

Oil.....

Drilling and Remarks:

Total Depth.....

Rgw up

PRODUCTION

1st 24 hrs. Nat.....

1st 24 hrs. after shot.....

Gas..... Cu. Ft.

Dry Hole.....

Abandoned.....

Date

MAY 20 1931

CHAS. L. SHERWOOD

192..... Scout

Beagwick

Map No. *13* **KANSAS** Sec. *15* Twp. *26* R. *7^E*

Well No. *3* *Hyannis*

Shell Gas Corp Company

Contractor

COMPLETED

SECTION PLAT

..... Ft. from N. Line

330 Ft. from S. Line

..... Ft. from E. Line

405 Ft. from W. Line

Location.....

Rig up.....

Drilling and Remarks:

*Pump Est
1700 Bbls.*

RECORD

Cased..... in., ft.

Sand *Uola 3192-97*

Gas.....

Oil.....

Total Depth *3197*

PRODUCTION

1st 24 hrs. Nat.....

1st 24 hrs. after shot.....

Gas..... Cu. Ft.

Dry Hole.....

Abandoned.....

Date

JUN 1 0 1931

192 **CHAS. L. SHERWOOD** Scout