

Section 3 Township 27 Range 7E

Well No. #1 Edna Lucas

Company K. T. Weidemann

NORTH

WEST

EAST

SOUTH

0

Butler

KANSAS ✓

Sec. 3 Twp. 27 R. 7E

Well No. #1 Edna Lucas Farm

K. T. Weidemann Company

Contractor

 Ft. from N. Line

330


 Ft. from S. Line

 Ft. from E. Line

330

 Ft. from W. Line

SW SW SE

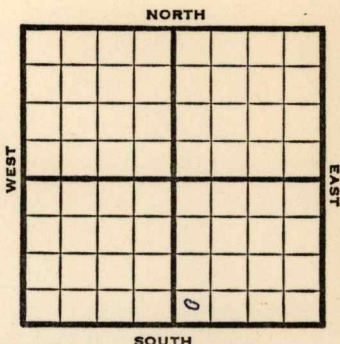

1952

Elev. 1496'

REPORT

7/30

8" Set

9/10

Spud 8-10-52

Oil Well TD 2732'

10" @ 75'

Bart. 2709

TD 2715 5" @ 2709 DD 2732

Hydro. Comp. 20 bopd

COMPLETED

County **Butler** State **Kansas**
 Sec. **3** (Blk. Twp.) **27** (Sur. Rge.) **7E** Map No.
 Operator **K. T. Weidemann**
 Well No. **1** Farm **Edna Lucas**
 Elev. Location **SW SW SE**

FIRST REPORT

6

330 Ft. From **S** Line **SE**

330 Ft. From **W** Line Quarter

1st. Report **JUL 30 1952**

Completion

Remarks

Spudding Date

Drlg. Data

8" set

County Butler State Kansas
Sec. 3 (Blk. 27 (Sur. 7E Map No.
(Twp. (Rge.)
Operator K. T. Weidemann
Well No. 1 Farm Edna Lucas
Elev. 1496 Location SW SW SE



330 Ft. From S Line SE

330 Ft. From W Line Quarter

1st. Report

Completion SEP 10 1952

Remarks

Spudding Date 8-10-52

Drlg. Data Oil well TD 2732

10" @ 75 Bart. 2709 TD 2715

5" @ 2709 DD 2732 Hydro.

Comp. 20 bopd

J. G. McGEHEE