

KANSAS


Barton

Section 7 Township 18 Range 13W

Well No. 1 Smith

Company: Florney & Williams

Yeakley Pool

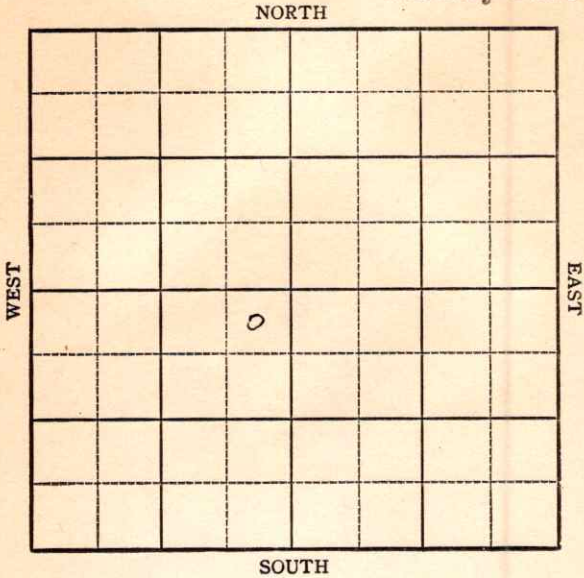

Sec. 7 Twp. 18 R. 13-W ✓

Well No. #1 Smith Farm

Florney & Williams Company
Yeakley


330 Ft. from N. Line

Ft. from S. Line

330 Ft. from E. Line

Ft. from W. Line

NE SW

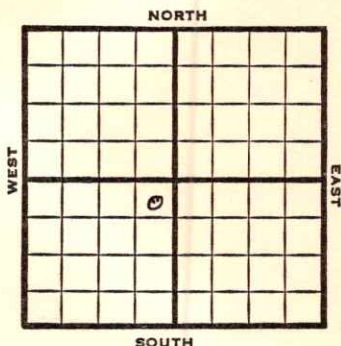

1948

Elev 1844' REPORT

11/3

8"@ 497'

Anhy 775

Drlg 1848'

11/10

Lansing 3099'

Arb. 3317'

TD 3320'

5"@ 3317'

11/16

TD 3329'

500 acid

2700' oil 13 hrs.

11/23

"

11/30

"

12/15

"

12/22

Arb. 3317'

5"@ 3317'

500 acid

Pump 297 oilPot

Gr. 36°

TD 3329'

Comp

COMPLETED

Map No. _____ Sec. 7 Twp. 18 R. 13WWell No. 1 SmithFlorney & Williams CompanyFIRST REPORT Contractor

NE SW


SECTION PLAT

330 Ft. from N. Line

_____ Ft. from S. Line

330 Ft. from E. Line

_____ Ft. from W. Line

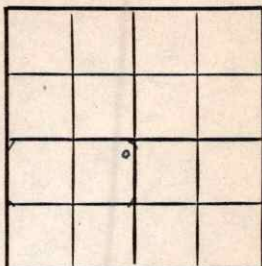Barton County

RECORD

Location _____

Rig up _____

Drilling and Remarks:

8" @ 497

Anhy 775

drlg. 1848

Cased _____ in., _____ ft.

Sand _____

Gas _____

Oil _____

Total Depth _____

PRODUCTION

1st 24 hrs. Nat. _____

1st 24 hrs. after shot _____

Gas _____ Cu. Ft.

Dry Hole _____

Abandoned _____

Date

NOV 3 1948 19S. J. LEWIS

Scout

Kansas


Yeakley Pool

Map No. 73 Sec. 7 Twp. 18 R. 13WWell No. 1 SmithFlerney & Williams Company

COMPLETE

Contractor

NE SW

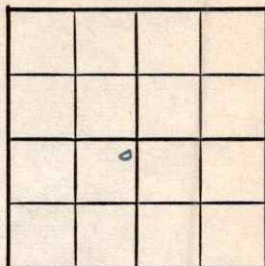E. 1844
SECTION PLAT330 Ft. from N. Line Ft. from S. Line330 Ft. from E. Line Ft. from W. Line

Barton County

Location Rig up

Drilling and Remarks:


RECORD

Cased in., ft.Sand Gas Oil Total Depth *9324*

PRODUCTION

1st 24 hrs. Nat. 1st 24 hrs. after shot Gas Cu. Ft.Dry Hole Abandoned

Date

DEC 22 1948

19

S. J. LEWIS

Scout