

KANSAS

Section 3 Township 18 Range 11WWell No. #1 G. PragerCompany N C R A

Wildcat

NORTH

WEST

EAST

							0

SOUTH

KANSAS

Barton

Sec. 3 Twp. 18 R. 11W

Well No. #1 G. Prager Farm

N C R A

Company

Wildcat

 Ft. from N. Line

990'


 Ft. from S. Line

330'

 Ft. from E. Line

 Ft. from W. Line

NE SE SE

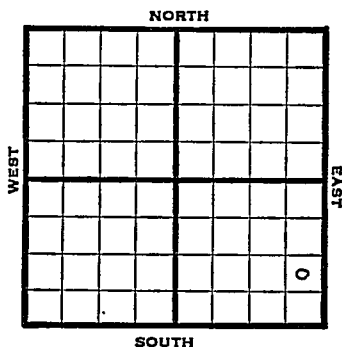

1948

Elev. 1801' REPORT

2/11

8" @ 218'
Drlg. 625'

2/18

Drlg 2730'

2/25

Lans. 3020'
Cong. 3304'
TD 3365'
Abd.

ABANDONED

Map No. _____ Sec. 3 Twp. 18 R. 11W

Well No. 1 G. Prager

N C R A


Company

FIRST REPORT

Contractor

NE SE SE

SECTION PLAT

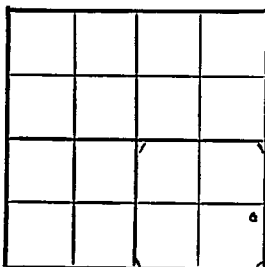

 Ft. from N. Line

990 Ft. from S. Line

330 Ft. from E. Line

 Ft. from W. Line

Barton County

Location _____

Rig up _____

Drilling and Remarks:

8" @ 218

drlg. 625

RECORD

Cased _____ in., _____ ft.

Sand _____

Gas _____

Oil _____

Total Depth _____

PRODUCTION

1st 24 hrs. Nat. _____

1st 24 hrs. after shot _____

Gas _____ Cu. Ft.

Dry Hole _____

Abandoned _____

Date

FEB 1 1 1948 19

S. J. LEWIS Scout

Map No. 55 Sec. 3 Twp. 18 R. 11W

Well No. 1 G. Prager

N C R A Company

ABANDONED Contractor

NE SE SE

E11501
SECTION PLAT

 Ft. from N. Line

990 Ft. from S. Line

330 Ft. from E. Line

 Ft. from W. Line

			o

Barton County

Location

Rig up

Drilling and Remarks:

Loss 3020
Conc 304

RECORD

Cased in., ft.

Sand

Gas

Oil

Total Depth 2265

PRODUCTION

1st 24 hrs. Nat.

1st 24 hrs. after shot

Gas Cu. Ft.

Dry Hole

Abandoned

Date

FEB 25 1948 19 S. J. LEWIS Scout