


Section 2 Township 27 Range 7E

Well No. #2 L. Lucas

Company Dunn & Strait

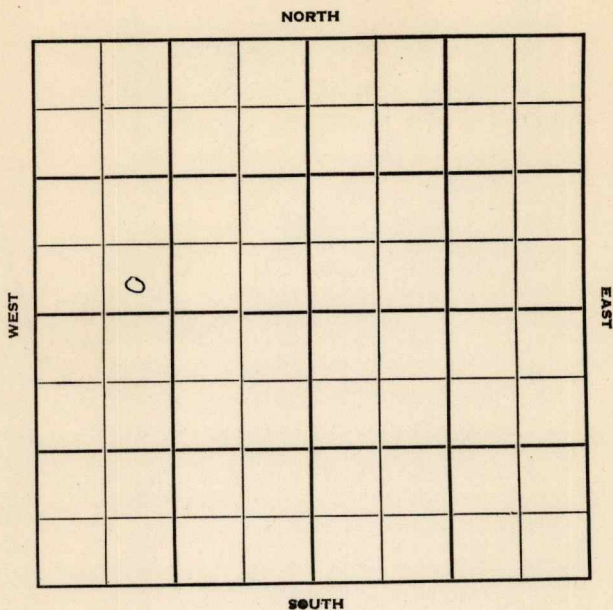

Butler

KANSAS

Sec. 2 Twp. 27 R. 7E

Well No. #2 L. Lucas Farm

Dunn & Strait Company

Dunn & Strait - Contr. Contractor


Ft. from N. Line

330' Ft. from S. Line

Ft. from E. Line

990' Ft. from W. Line

SE SW NW

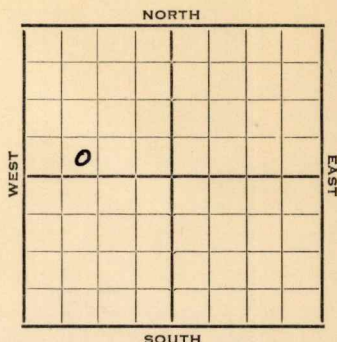

1952

Elev. 1497'

REPORT

2/13

RUR

3/26

Spud 2-14-52

Oil well TD 2700' 8" @ 75

Bart. 2666' 5" @ 2668' TD 2680'

B. Bart. 2678' TD 2700' 4 GPH

PB 2678' Hydro. 1½ BOPH

Comp. 20 BOPD

COMPLETED

County **Butler** State **Kansas**
 Sec. **2** (Blk.) **27** (Sur.) **7E** Map No.

Operator **Dunn & Strait**

Well No. **2** Farm **L. Lucas**

Elev. Location **SE SW NW**

0

FIRST REPORT

330 Ft. From **S** Line **NW**

990 Ft. From **W** Line Quarter

1st. Report **FEB 13 1952**

Completion

Remarks

Dunn & Strait - Contr.

Spudding Date

Drlg. Data

RUR

J. G. McGEHEE

