

Map No. _____ Sec. 3 Twp. 27 R. 7
Well No. 1 Houston Farm _____
Frontier O & R. Company _____

NORTH

WEST

EAST

SOUTH

Location _____

Drilling Remarks:

Rig up _____

Drilling Remarks:

RECORD

Cased _____ in. _____ ft.

Sand _____

Gas _____

Oil _____

Total Depth_____

PRODUCTION

1st 24 hrs Nat. _____

1st 24 hrs. after shot_____

Gas _____ cu. ft.

Dry Hole_____

Abandoned _____

Map No. _____ Sec. 3 Twp. 27 R. 7

Well No. 1 Houston Farm _____


Frontier O. & R. Company _____

200 Ft. from N. Line

_____ Ft. from S. Line

_____ Ft. from E. Line

1120 Ft. from W. Line

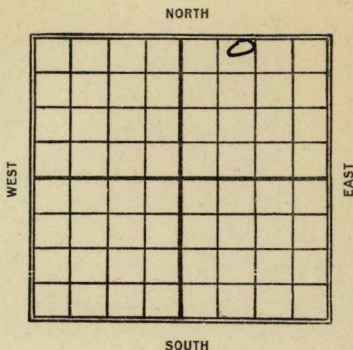

Date 1923

REPORT

6/23 D. & A. 2740'

Map No. **KANSAS** 10 Sec. 3 Twp. 27 R. 7Well No. 1 *Houston**Frontier Oil & Ref.* Company

FIRST REPORT

Contractor

ABANDONED SECTION PLAT

200 Ft. from N. Line

Ft. from S. Line

Ft. from E. Line

1120 Ft. from W. Line

		6	

Location

Rig up

Drilling and Remarks:

2049
2740'

RECORD

Cased _____ in., _____ ft.

Sand _____

Gas _____

Oil _____

Total Depth _____

PRODUCTION

1st 24 hrs. Nat. _____

1st 24 hrs. after shot _____

Gas _____ Cu. Ft.

Dry Hole _____

Abandoned _____

Date

JUN 23 1923

192

M. A. BENEAR

Scout