

KANSAS

Sedgwick

FORM 51 25M 3-49 PETROL

Section 15 Township 26 Range 2-E


Well No. #3 Lygrisse "A"

Company W R Justice

NORTH

WEST

EAST

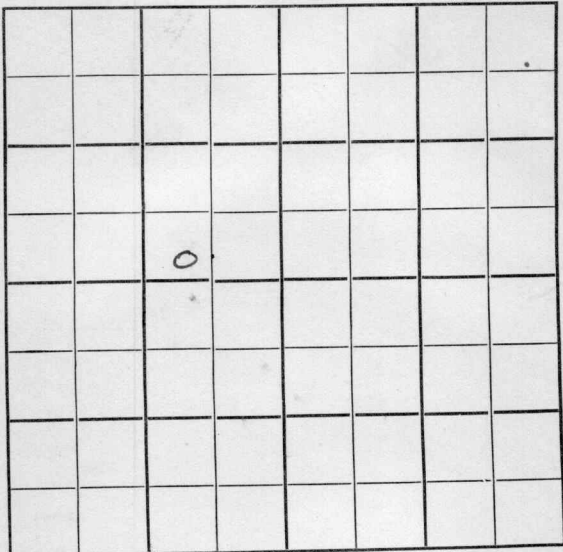

SOUTH

Sec. 15 Twp. 26 R. 2-E

Well No. #3 Lygrisse "A" Farm

W R Justice Company

Laura Jane Greenwich Contractor

Ft. from N. Line

525
~~330~~


Ft. from S. Line

1300 Ft. from E. Line

~~990~~ Ft. from W. Line

~~SE SW NW~~

SW SE NW.

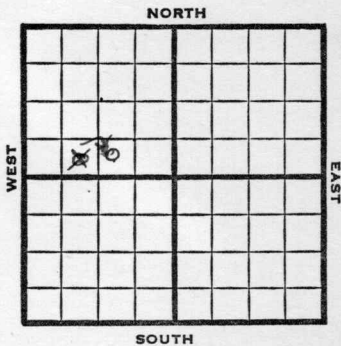

1950

Elev 1379'

REPORT

2/15

Spud 2-11-50
8 5/8" @ 90'
Drlg 1800'

3/1

8-5/8" @ 90'
5" @ 2868'
Miss 2867'
20 BOPD
TD 2874'

COMPLETED

Map No. _____ Sec. 15 Twp. 26 R. 2E

Well No. 3 Lygrisse "A"

W. R. Justice Company

Laura Jane Contractor

SE SW NW

SECTION PLAT

_____ Ft. from N. Line

330 Ft. from S. Line

_____ Ft. from E. Line

990 Ft. from W. Line

FIRST REPORT

Sed gwick County

Location _____

Rig up _____

Drilling and Remarks:

Spud 2-11-50

8 5/8" @ 90

drlg. 1800

RECORD

Cased _____ in., _____ ft.

Sand _____

Gas _____

Oil _____

Total Depth _____

PRODUCTION

1st 24 hrs. Nat. _____

1st 24 hrs. after shot _____

Gas _____ Cu. Ft.

Dry Hole _____

Abandoned _____

Date

FEB 15 1950

19

J. E. TYRA

Scout

Kansas

Map No. _____ Sec. 15 Twp. 26 R. 2E

Well No. 3 Lygrisse "A"

W. R. Justice Company

CORRECTION

Contractor

SW SE NW

E1. 1379
SECTION PLAT

_____ Ft. from N. Line

525 Ft. from S. Line

1300 Ft. from E. Line

_____ Ft. from W. Line

	o		

Sedgwick County

Location _____

Rig up _____

Drilling and Remarks:

Reported

SE SW NW

RECORD

Cased _____ in., _____ ft.

Sand _____

Gas _____

Oil _____

Total Depth _____

PRODUCTION

1st 24 hrs. Nat. _____

1st 24 hrs. after shot _____

Gas _____ Cu. Ft.

Dry Hole _____

Abandoned _____

Date

FEB 22 1950

19

J. E. TYRA Scout

Kansas

Map No. _____ Sec. 15 Twp. 26 R. 2E

Well No. 3 Lygrisse "A"

W. R. Justice Company

Contractor

E. 1379

SECTION PLAT

SW SE NW

	o		
COMPLETE			

_____ Ft. from N. Line

525 _____ Ft. from S. Line

1300 _____ Ft. from E. Line

_____ Ft. from W. Line

Sedgwick County

Location _____

Rig up _____

Drilling and Remarks:

8 5/8" @ 90
5" @ 2868
miss 2867
20 B.O.P.D

RECORD

Cased _____ in., _____ ft.

Sand _____

Gas _____

Oil _____

Total Depth 2874

PRODUCTION

1st 24 hrs. Nat. _____

1st 24 hrs. after shot _____

Gas _____ Cu. Ft.

Dry Hole _____

Abandoned _____

Date

MAR 1 1950

19

J. E. TYRA Scout