
FORM 51

Barton KANSAS

Section 2 Township 18 Range 11 W

Well No. # 1 Fox

Company Petroleum Inc.

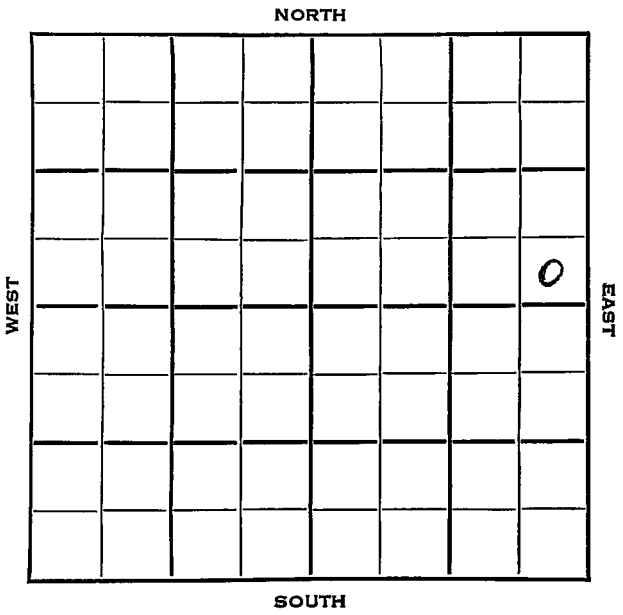

Barton KANSAS

SEC.	TWP.	R.
2	18	11W

WELL NO. #1 Fox FARM

COMPANY Petroleum Inc.

CONTRACTOR Garvey


_____ Ft. from N. Line

330 Ft. from S. Line

330 Ft. from E. Line

_____ Ft. from W. Line

SE SE NE

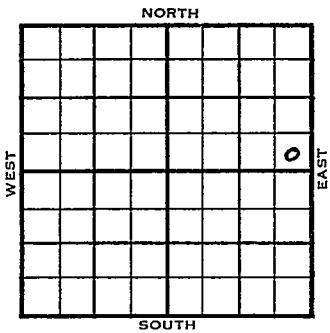

	ELEVATION 1800' REPORT
1953	
10/14	Spud 10-11-53 8" @ 253' WOC
10/21	Heeb 2890 Br li 2994 Lans 3010 DST 3026-41, 1 hr, 770' SW 950# Drlg. 3190'
10/28	Spud 10-11-53 D & A TD 3355 8" @ 253 Heeb 2890 Br lime 2994 Lans. 3010' DST 3026-41 open 1 hr rec 770' SW 950# Cong. 3297 Arb. 3346' TD 3355 D & A

ABANDONED

DX-78

FORM 275 FOR SALE BY KANSAS BLUE PRINT CO.


County Barton State Kansas

Sec. 2 (Blk. Twp.) 18 (Sur. Rge.) 11W Map No.

Operator Petroleum Inc.

Well No. 1 Farm Fox

Elev. Location SE SE NE

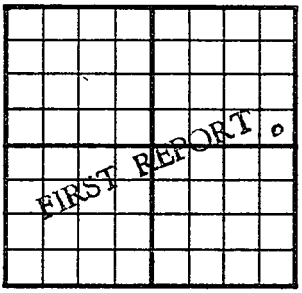

330 Ft. From S Line NE

330 Ft. From E Line Quarter

1st. Report OCT 14 1953

Completion

Remarks

Garvey - Contr.

Spudding Date 10-11-53

Drlg. Data

8" @ 253 WOC

J. G. McGEHEE

FORM 275 FOR SALE BY KANSAS BLUE PRINT CO


County Barton State Kansas

Sec. 2 (Blk. Twp.) 18 (Sur. Rge.) 11W Map No.

Operator Petroleum Inc.

Well No. 1 Farm Fox

Elev. 1800 Location SE SE NE

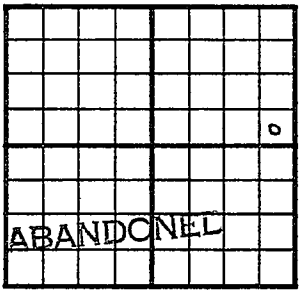

330 Ft. From S Line NE

330 Ft. From E Line Quarter

1st. Report

Completion OCT 2 8 1953

Remarks

Garvey - Contr.

Spudding Date 10-11-53

Drlg. Data D & A TD 3355

8" @ 253 Heeb. 2890 Br. lime 2994

Lans. 3010 DST 3026-41 open 1 hr.

Rec. 770' sw 950# Cong. 3297

Arb. 3346 TD 3355

D & A

J. G. McGEHEE