

Section 2 Township 18 Range 11W

Well No. #1 Grizzell

Company Todd Drlg. et al

NORTH

West

EAST

6

SOUTH

Barton **KANSAS**
11W

Sec. 2 Twp. 18 R. 11W

Well No. #1 Grizzell Farm

Todd Drlg. et al Company

Todd Drlg. - Contr. Contractor
Bloomer Pool


 Ft. from N. Line

330' Ft. from S. Line

330' Ft. from E. Line

 Ft. from W. Line

SE SE SE

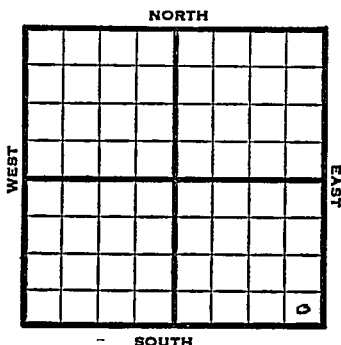

1950 Elv. 1794' REPORT

11/22 RUR

12/6 Spud 11-23-50

D&A TD 3396

8" @ 256

Anhy 596-620 Heeb. 2902


Br Lime 3016 Lans. 3031

Cong. 3301 Arb. 3346 TD 3396'

D&A

ABANDONED


County Barton State Kansas
 Sec. 2 (Blk. 18 (Sur. 11W Map No.
 (Twp.) (Rge.)
 Operator Todd Drlg. etal.
 Well No. 1 Farm Grizzell
 Elev. Location SE SE SE

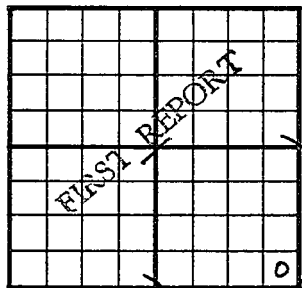

330 Ft. From S Line SE
 330 Ft. From E Line Quarter
 1st. Report NOV 22 1950
 Completion
 Remarks
 Todd Drlg. - Contr.
 Spudding Date

Drlg. Data Bloomer Pool

R U R

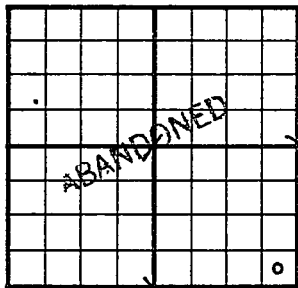County Barton State KansasSec. 2 (Blk.) 18 (Sur.) 11W Map No.Operator Todd Drlg. etal.Well No. 1 Farm GrizzellElev. 1794 Location SE SE SE330 Ft. From S Line SE330 Ft. From E Line Quarter

1st. Report

Completion DEC 6 1950Remarks Bloomer Pool.Todd Drlg. - Contr.Spudding Date 11-23-50Drlg. Data D & A TD 33968" @ 256 Anhy 596-620 Heeb. 2902Br. lime 3016 Lans. 3031 Congr. 3301Arb. 3346-96 TDD & A