

KANSAS

Barton

Section 27 Township 20 Range 12W

Well No. 2 Bryant "B"

Company Alpine Oil & Royalty

Bryant

NORTH

WEST

EAST

							0

SOUTH

KANSAS

Barton

Sec. 27 Twp. 20 R. 12W

Well No. #2 Bryant "B" Farm

Alpine Oil & Royalty Company

Bryant Pool


990' Ft. from N. Line

 Ft. from S. Line

330' Ft. from E. Line

 Ft. from W. Line

SE NE SE

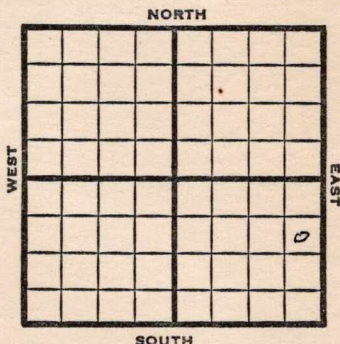

1949	Elev 1831'	REPORT
3/23	8" @ 289'	
	Anhy. 600'	
	Drlg. 1840'	
3/30	Lansing 3142'	
	Arb. 3377-79'	
	TD 3379'	
	5"@ 3377&	
4/6	TD 3387'	
	1000 acid swb 5 bbls oil FH	
4/12	"	
4/20	"	
4/27	TD 3387'	
	Arb. 3377'	
	5"@ 3377'	
	1000 acid	
	Pump 158 Oil + 3% W Pot	
	40° Gr.	
	Comp	
	COMPLETED	

Kansas


Map No. _____ Sec. 27 Twp. 20 R. 12WWell No. 2 Bryant "B"Alpine Oil & Royalty CompanyFIRST REPORT Contractor

SE NE SE

SECTION PLAT

990 Ft. from N. Line Ft. from S. Line330 Ft. from E. Line Ft. from W. Line

Barton County

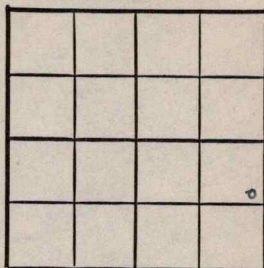

Location _____

Rig up _____

Drilling and Remarks:

8" @ 289

Anhy 600

drlg. 1840

RECORD

Cased _____ in., _____ ft.

Sand _____

Gas _____

Oil _____

Total Depth _____

PRODUCTION

1st 24 hrs. Nat. _____

1st 24 hrs. after shot _____

Gas _____ Cu. Ft.

Dry Hole _____

Abandoned _____

Date

MAR 23 1949

19

S. J. LEWIS

Scout

Bryant Pool

Kansas

Map No. K46 Sec. 27 Twp. 20 R. 12WWell No. 2 Bryant "B"


Alpine Oil & Royalty

Company

COMPLETE

Contractor

SE NE SE

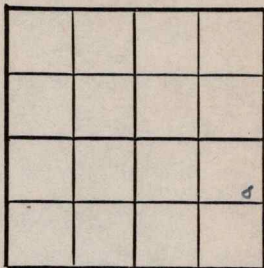E. 1/4
SECTION PLAT990 Ft. from N. Line Ft. from S. Line330 Ft. from E. Line Ft. from W. Line

Barton County

Location Rig up

Drilling and Remarks:

Art 33775" @ 33771000 acidPump 1500 ft. to 1000BT40° N

RECORD

Cased in., ft.Sand Gas Oil Total Depth 2387

PRODUCTION

1st 24 hrs. Nat. 1st 24 hrs. after shot Gas Cu. Ft.Dry Hole Abandoned

Date

APR 27 1949

19

S. J. LEWIS

Scout