

KANSAS

Section 7 Township 18 Range 13W

Well No. 2 Smith

Company Florney & Williams

Eveleight
NORTH



KANSAS

Barton

Sec. 7 Twp. 18 R. 13W

Well No. 2 Smith Farm

Florney & Williams Company


Eveleigh Pool Florney & Williams-Contr.

660 Ft. from N. Line

_____ Ft. from S. Line

990 Ft. from E. Line

_____ Ft. from W. Line

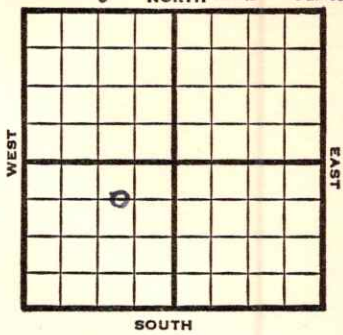

C W L NE SW

1949 **1848 DF** REPORT

9/28 RUR
 10/5 8" @ 783'
 Drlg 2990'
 10/12 **Arb. 3319'**
 TD 3321'
 5" @ 3320'
 10/19 TD 3336'
 Swb 20 bbls oil PH 3 hrs.
 10/26 Acid 1000
 11/2 TD 3336'
Arb. 3319'
 5" @ 3320'
 1000 acid
 Pump 571 Oil Pot
 36° Gr.
 Comp

COMPLETED

Map No. _____ Sec. 7 Twp. 18 R. 13W

Well No. 2 Smith

Florney & Williams Company

Florney & Williams Contractor

C W L NE SW

FIRST SECTION PLAT

660 Ft. from N. Line

_____ Ft. from S. Line

990 Ft. from E. Line

_____ Ft. from W. Line

	o		

Barton County

RECORD

Location _____

Cased _____ in., _____ ft.

Rig up _____

Sand _____

Drilling and Remarks:

Gas _____

Oil _____

Total Depth _____

R U R

PRODUCTION

1st 24 hrs. Nat. _____

1st 24 hrs. after shot _____

Gas _____ Cu. Ft.

Dry Hole _____

Abandoned _____

Date

SEP 28 1949 19

S. J. LEWIS Scout

Kansas

Map No. _____ Sec. 7 Twp. 18 R. 13WWell No. 2 Smith

_____ Florney - Williams _____ Company

COMPLETE

Contractor


C W L NE SW

E. 1848
SECTION PLAT660 Ft. from N. Line

_____ Ft. from S. Line

990 Ft. from E. Line

_____ Ft. from W. Line

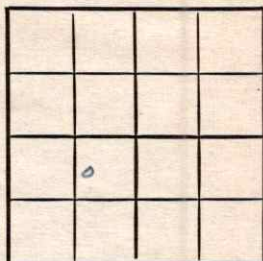

Barton County

Location _____

Rig up _____

Drilling and Remarks:

Cor 83319
5" @ 3328
10000 cu ft
Pump 571 oil
26 2/3

RECORD

Cased _____ in., _____ ft.

Sand _____

Gas _____

Oil _____

Total Depth 3326

PRODUCTION

1st 24 hrs. Nat. _____

1st 24 hrs. after shot _____

Gas _____ Cu. Ft.

Dry Hole _____

Abandoned _____

Date

NOV 2 1949

19

S. J. LEWIS

Scout