

KANSAS

Barton

Section 7 Township 18 Range 13WWell No. 3 SmithCompany Birmingham & Bartlett

Eveleigh

NORTH

WEST

						0	

EAST

SOUTH

KANSAS

Barton

Sec. 7 Twp. 18 R. 13W

Well No. #3 Smith Farm

Birmingham & Bartlett

Company

Eveleigh Pool


 Ft. from N. Line

970' Ft. from S. Line

990' Ft. from E. Line

 Ft. from W. Line

NW SE SE

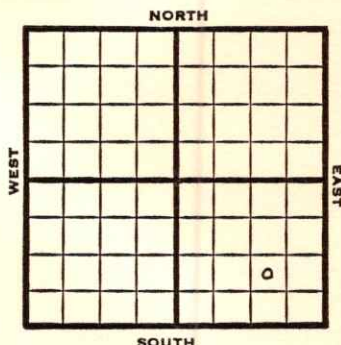

1949

Elev 1839'

R E P O R T

4/20	Surface Hole
4/27	8"@ 769'
	Drlg 2550'
5/4	Lansing 3100
	Arb. 3316 so
	TD 3316
	5"@ 3318'
5/10	TD 3322'
	250 acid Swb 84 bbls fluid 9 hrs.
5/18	"
5/25	TD 3322'
	Arb. 3316'
	5"@ 3318
	250 acid
	Pump 366 Oil Pot
	38° Gr.
	Comp
	COMPLETED

Kansas

Map No. _____ Sec. 7 Twp. 18 R. 13WWell No. 3 Smith_____ Birmingham & Bartlett Company_____ FIRST REPORT Contractor
NW SE SE

SECTION PLAT

_____ Ft. from N. Line

970 Ft. from S. Line990 Ft. from E. Line

_____ Ft. from W. Line

Barton County

Location _____

Rig up _____

Drilling and Remarks:

surface hple

RECORD

Cased _____ in., _____ ft.

Sand _____

Gas _____

Oil _____

Total Depth _____

PRODUCTION

1st 24 hrs. Nat. _____

1st 24 hrs. after shot _____

Gas _____ Cu. Ft.

Dry Hole _____

Abandoned _____

Date

APR 20 194919S. J. LEWISScout

Map No. K 73 Sec. 7 Twp. 18 R. 13WWell No. 3 SmithBirmingham & Bartlett Company**COMPLETE**

Contractor

NW SE SE

E 1/4 1/4
SECTION PLAT Ft. from N. Line970 Ft. from S. Line990 Ft. from E. Line Ft. from W. Line

			0

Barton County

Location Rig up

Drilling and Remarks:

As 83316
5" @ 3318
250000'
Prod 366 oil
350'

RECORDCased in., ft.Sand Gas Oil Total Depth 2822**PRODUCTION**1st 24 hrs. Nat. 1st 24 hrs. after shot Gas Cu. Ft.Dry Hole Abandoned

Date

MAY 25 1949

19

S. J. LEWIS

Scout