

Barton County


KANSAS

Section 7 Township 18 Range 13W

Well No. 2 Smith

Company Republic Natural Gas

NORTH

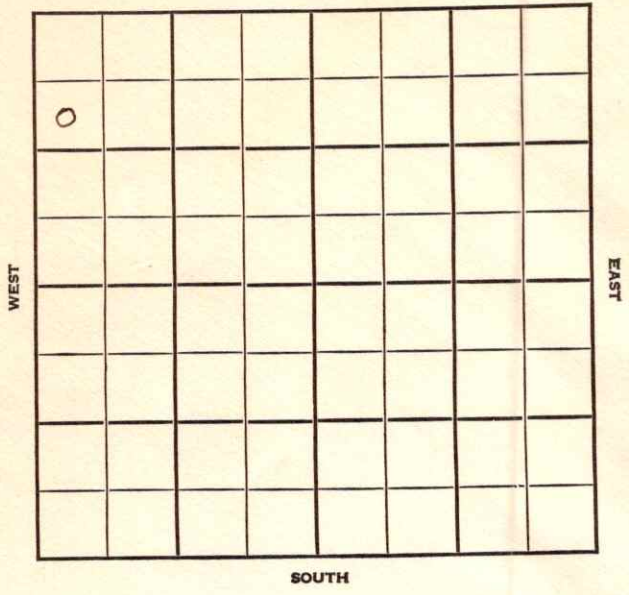

SOUTH

Sec. 7 Twp. 18 R. 13W

Well No. #2 Smith Farm

Republic Natural Gas Company

Evelèigh


990 Ft. from N. Line

\_\_\_\_\_ Ft. from S. Line

\_\_\_\_\_ Ft. from E. Line

330 Ft. from W. Line

SW NW NW

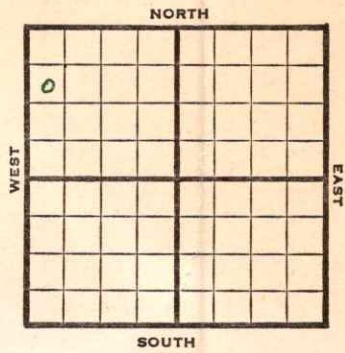

1947 **Elev. 1838'** REPORT

12/30 8" @ 793'  
Drlg. 2025'

1948  
1/7 **Lansing 3085'**  
**Arbuckle 3334-36' TD**  
7" @ 3335'  
RUST

1/14 TD 3343'  
500 acid

1/21 TD 3347'  
1000 Acid HFW  
PB 3343'  
1000 Acid HFW PB

1/26 "

2/4 **Arb. 3334'**  
7" @ 3335'  
TD 3347'  
Abd.

**ABANDONED**

Map No. \_\_\_\_\_ Sec. 7 Twp. 18 R. 13W

Well No. 2 Smith

Republic Natural Gas Company

FIRST REPORT Contractor

SW NW NW

SECTION PLAT

990 Ft. from N. Line

\_\_\_\_\_ Ft. from S. Line

\_\_\_\_\_ Ft. from E. Line

330 Ft. from W. Line

o			

Barton County

Location \_\_\_\_\_

Rig up \_\_\_\_\_

Drilling and Remarks:

8" @ 793

drlg. 2025

RECORD

Cased \_\_\_\_\_ in., \_\_\_\_\_ ft.

Sand \_\_\_\_\_

Gas \_\_\_\_\_

Oil \_\_\_\_\_

Total Depth \_\_\_\_\_

PRODUCTION

1st 24 hrs. Nat. \_\_\_\_\_

1st 24 hrs. after shot \_\_\_\_\_

Gas \_\_\_\_\_ Cu. Ft.

Dry Hole \_\_\_\_\_

Abandoned \_\_\_\_\_

Date

DEC 30 1947 19

S. J. LEWIS Scout

Map No. 73 Sec. 7 Twp. 18 R. 13W

Well No. 2 Smith

Republic Natural Gas Company

**ABANDONED**

Contractor

SW NW NW

*E. 1838*

**SECTION PLAT**

990 Ft. from N. Line

\_\_\_\_\_ Ft. from S. Line

\_\_\_\_\_ Ft. from E. Line

330 Ft. from W. Line

6			

Barton County

Location \_\_\_\_\_

Rig up \_\_\_\_\_

Drilling and Remarks:

*Ar 334*  
*7" 335*

**RECORD**

Cased \_\_\_\_\_ in., \_\_\_\_\_ ft.

Sand \_\_\_\_\_

Gas \_\_\_\_\_

Oil \_\_\_\_\_

Total Depth 334

**PRODUCTION**

1st 24 hrs. Nat. \_\_\_\_\_

1st 24 hrs. after shot \_\_\_\_\_

Gas \_\_\_\_\_ Cu. Ft.

Dry Hole \_\_\_\_\_

Abandoned \_\_\_\_\_

Date

FEB 4 1948

19

S. J. LEWIS

Scout