


Section 3 Township 18 Range 11W

Well No. #1 Simmons

Company Pabeo Drig. Francis Raymond

NORTH

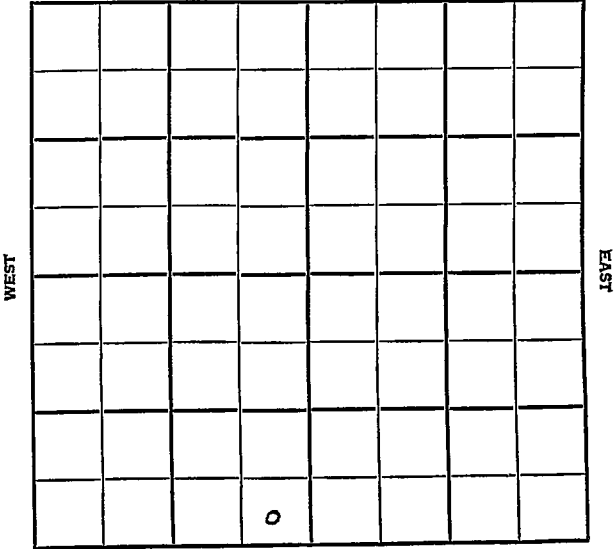

SOUTH

Barton

KANSAS

SEC.	TWP.	R.
3	18	11W

WELL NO.

#1 Simmons

FARM

COMPANY

FRANCIS RAYMOND
~~Pabco Drlg.~~

CONTRACTOR

Pabco


Wildcat

_____ Ft. from N. Line

330 _____ Ft. from S. Line

330 _____ Ft. from E. Line

_____ Ft. from W. Line

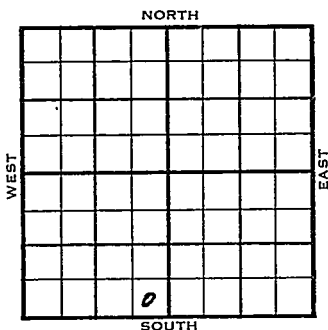

SE SE SW

	ELEVATION	REPORT
1954	1798'	
10/13	Spud 10-9-54 8" @ 230' Drlg. 1875'	
1955 1/5	Spud 10-9-54 Oil Well TD 3362' 8" @ 230' Anhy 620', Heeb 2901' Br. Lime 3010' Lans 3024' DST 3012'-40 opn 1 hr, rec 60' Mud 110# X DST 3067'-3107' opn 45 min, rec 129' hocm, 124' oil, 1050# Cong 3312' Arb. 3346' DST 3347-51' opn 45 min, rec 20' Mud Off TD 3351' 5" @ 3348' DD 3362 PB 3336 6/ 3238-41 6/ 3244-4 16/ 3253-57 4/ 3190-92 8/ 3197-3201 6/ 3205-08 10/ 3162-67 12/ 3114-20 11/ 3125-36 11/ 3076-80 24/ 3094- 3106 8/ 3044- 48 2400 A Wtr. 3000 A 95 bo 60 bw. 24 hr. P/ 83 bo 60 bw. 24 hr. P/18 bo Comp 25 bond	

Kansas

Map No. _____ Sec. 3 Twp. 18 R. 11W

Well No. 1 Simmons

Francis Raymond Company

Contractor

SE SE SW


_____ Ft. from N. Line

330 Ft. from S. Line

330 Ft. from E. Line

_____ Ft. from W. Line

SECTION PLAT

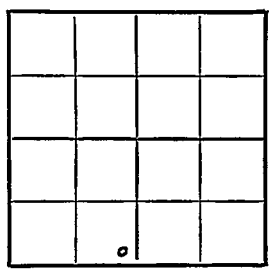

Barton County

Location _____

Rig up _____

Drilling and Remarks:

Reported
Pabco Drig.

RECORD

Cased _____ in., _____ ft.

Sand _____

Gas _____

Oil _____

Total Depth 270

PRODUCTION

1st 24 hrs. Nat. _____

1st 24 hrs. after shot _____

Gas _____ Cu. Ft.

Dry Hole _____


Abandoned _____

Date

OCT 20 1954

FABEN GILSTRAP
Scout

County Barton State Kansas
 Sec. 3 (Blk.) 18 (Sur. Rge.) 11W Map No.
 Operator Francis Raymond
 Well No. 1 Farm Simmons
 Elev. 1798 Location SE SE SW'

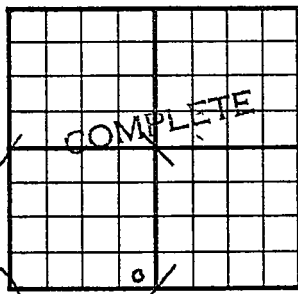

330 Ft. From S Line SW
330 Ft. From E Line Quarter
 Ist. Report
 Completion JAN 5 1955
 Remarks Wildcat
Pabco Drlg. - Contr.
 Spudding Date 10-9-54

Drlg. Data Oil well TD 3362
8" @ 230 Anhy 620 Heeb. 2901
Br. lime 3010 Ians. 3024 DST 3012-40
open 1 hr. Rec. 60' mud 110#
DST 3067-3107 open 45 min. Rec. 129'
hoem 124' oil 1050# Cong. 3312
Arb. 3346 DST 3347-51 open 45 min.
Rec. 20' mud 0# TD 3351 5" @ 3348
DD 3362 PB 3336 6/ 3238-41 6/ 3244-47
16/ 3253-57 4/ 3190-92 8/ 3197-3201
6/ 3205-08 10/ 3162-67 12/ 3114-20
11/ 3125-36 11/ 3076-80 24/ 3094-3106
8/ 3044-48 2400 A wtr. 3000 A
95 bo 60 bw 24 hr. P/ 83 bo 60 bw
24hr. P/ 18 bo Comp. 25 bopd

FABEN GILSTRAP