



WEST

EAST

SOUTH

Location _____

Drilling Remarks:

Rig up _____

Drilling Remarks:

RECORD

Cased _____ in. _____ ft.

Sand _____

Gas _____

Oil _____

Total Depth_____

PRODUCTION

1st 24 hrs Nat. _____

1st 24 hrs. after shot_____

Gas _____ cu. ft.

Dry Hole

Abandoned _____

Map No. _____ Sec. 5 Twp. 27 R. 7

Well No. 1 Coulter Farm _____
Ray Ekal Company _____

NORTH

1120 Ft. from N. Line


_____ Ft. from S. Line

200 Ft. from E. Line

_____ Ft. from W. Line

WEST

EAST

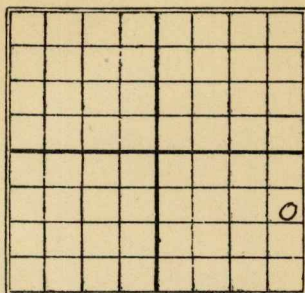

SOUTH

Date

REPORT

1923
2/24
6/10

Rig
D. & 9-2900'

Map No. ¹⁰ ~~141312~~ Sec. ⁵ Twp. ²⁷ R. ⁷

Well No. ¹ *Caulter*

Ray et al Company

Contractor

FIRST REPORT

SECTION PLAT

1120 Ft. from N. Line

Ft. from S. Line

200 Ft. from E. Line

Ft. from W. Line

Location

Rig up

Drilling and Remarks:

RECORD

Cased in., ft.

Sand

Gas

Oil

Total Depth

PRODUCTION

1st 24 hrs. Nat.

1st 24 hrs. after shot

Gas Cu. Ft.

Dry Hole

Abandoned

Date

FEB 24 1923

M. A. BENEAR

Map No. **KANSAS** 10 3 Sec. 27 R. 7
Well No. 1 *Cumtaw*
Ray et al Company
Contractor

ABANDONED SECTION PLAT

1120 Ft. from N. Line
Ft. from S. Line
200 Ft. from E. Line
Ft. from W. Line

			3

Location
Rig up
Drilling and Remarks:
2049
2900'

RECORD
Cased _____ in., _____ ft.
Sand _____
Gas _____
Oil _____
Total Depth _____

PRODUCTION
1st 24 hrs. Nat. _____
1st 24 hrs. after shot _____
Gas _____ Cu. Ft.
Dry Hole _____
Abandoned _____