

KANSAS

Barton


Section 7 Township 18 Range 13WWell No. 4 SmithCompany Birmingham & Bartlett

Eveleigh Pool

NORTH

WEST

EAST

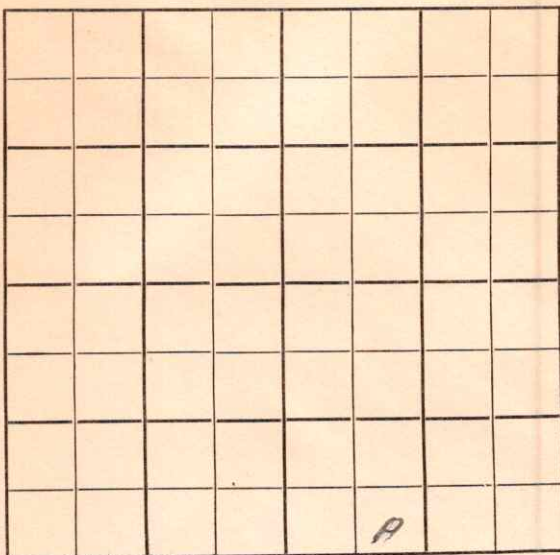

SOUTH

KANSAS

Barton

Sec. 7 Twp. 18 R. 13W 

Well No. #4 Smith Farm

Birmingham & Bartlett Company

Eveleigh Pool

 Ft. from N. Line


330'

 Ft. from S. Line

 Ft. from E. Line

990'

 Ft. from W. Line

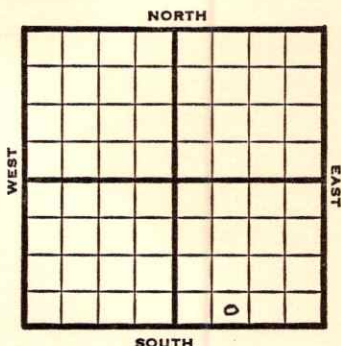

SE SW SE

SOUTH

1949

Elev 1858'

REPORT

5/4

RUR

5/10

8" @ 787'

Drlg 2745'

5/18

Lansing 3119'

Arb. 3349'

5 @ 3350-52

TD 3352'

300 acid

5/ 25

TD 3352'

Arb. 3349'

5 @ 3350'

300 acid

Pump 423 Oil Pot

38° Gr.

Comp

COMPLETED

Kansas

Map No. _____ Sec. 7 Twp. 18 R. 13WWell No. 4 Smith

Birmingham & Bartlett Company

FIRST REPORT

Contractor

SE SW SE

SECTION PLAT

_____ Ft. from N. Line

330 Ft. from S. Line

_____ Ft. from E. Line

990 Ft. from W. Line

Barton County

Location _____

Rig up _____

Drilling and Remarks:

R U R

RECORD

Cased _____ in., _____ ft.

Sand _____

Gas _____

Oil _____

Total Depth _____

PRODUCTION

1st 24 hrs. Nat. _____

1st 24 hrs. after shot _____

Gas _____ Cu. Ft.

Dry Hole _____

Abandoned _____

Date

MAY 4 1949

19

S. J. LEWIS


Scout

Kansas

Map No. 1573 Sec. 7 Twp. 18 R. 13WWell No. 4 SmithBirmingham & Bartlett Company**COMPLETE**

Contractor

SE SW SE

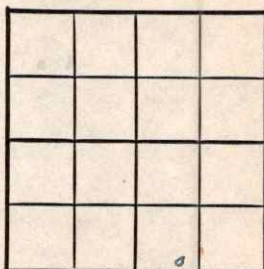E. 1858
SECTION PLAT Ft. from N. Line330 Ft. from S. Line Ft. from E. Line990 Ft. from W. LineBarton CountyLocation Rig up

Drilling and Remarks:

CR 4334951103300200 acidPump 423 oil 638-0-0**RECORD**Cased in., ft.Sand Gas Oil Total Depth 3302**PRODUCTION**1st 24 hrs. Nat. 1st 24 hrs. after shot Gas Cu. Ft.Dry Hole Abandoned

Date

MAY 25 1949 19S. J. LEWIS

Scout