

KANSAS

Barton

Section 8 Township 18 Range 13WWell No. 1 Reid1Company Harbar Drlg.

Yeakley Pool

NORTH

WEST

EAST

0							

SOUTH

KANSAS

Barton

Sec. 8 Twp. 18 R. 13W ✓

Well No. #1 Reidl Farm

Harbar Drlg. Company

Yeakley Pool


 Ft. from N. Line

330' Ft. from S. Line

 Ft. from E. Line

330' Ft. from W. Line

SW/c

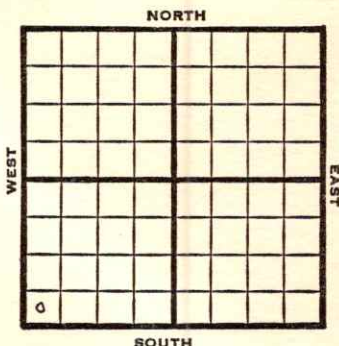

1948

Eli 1834'

REPORT

11/23 Location
11/30 8" @ 770 - 1790' fsg.
12/8 Surface pipe parted
TD 2665 skidrig
50' SW
12/15 8" @ 765
rlg 1613
12/22 **Arb. 3332'**
Drlg 3335'
12/29 TD 3339'
Lans 3094'
Arb 3332'
Aband.

ABANDONED

Map No. _____ Sec. 8 Twp. 18 R. 13W

Well No. 1 Reidl


Harbar Drlg. Company

FIRST REPORT

Contractor

SW/C

SECTION PLAT

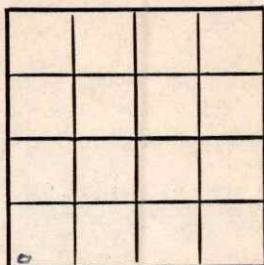

_____ Ft. from N. Line

330 Ft. from S. Line

330 Ft. from E. Line

330 Ft. from W. Line

Barton County

Location X

Rig up _____

Drilling and Remarks:

RECORD

Cased _____ in., _____ ft.

Sand _____

Gas _____

Oil _____

Total Depth _____

PRODUCTION

1st 24 hrs. Nat. _____

1st 24 hrs. after shot _____

Gas _____ Cu. Ft.

Dry Hole _____

Abandoned _____

Date

NOV 23 1948 19

S. J. LEWIS Scout

Map No. 73 Sec. 8 Twp. 18 R. 13WWell No. 1 Reidl

Harbar Drlg.

Company

ABANDONED

Contractor

SW/C

SECTION PLAT

Ft. from N. Line

330 Ft. from S. Line

Ft. from E. Line

330 Ft. from W. Line

Barton County

Location

Rig up

Drilling and Remarks:

Lease 3094Ac 3332

RECORD

Cased _____ in., _____ ft.

Sand _____

Gas _____

Oil _____

Total Depth 3339

PRODUCTION

1st 24 hrs. Nat. _____

1st 24 hrs. after shot _____

Gas _____ Cu. Ft.

Dry Hole _____

Abandoned _____

Date

DEC 29 1948 19

S. J. LEWIS

Scout