


Section 6 Township 27 Range 7-E

Well No. 1 Lindley

Company Chas. Johnson et al

NORTH Miscellaneous

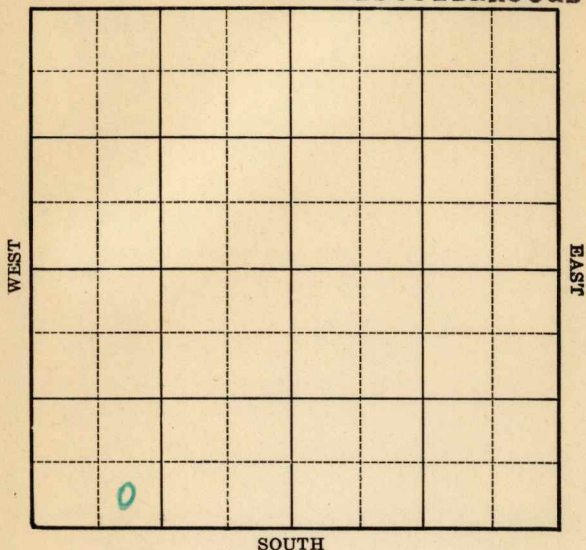


Map No. 10 Sec. 6 Twp. 27 R. 7EWell No. 1 Lindley

Chas. Johnson etal Company

FIRST REPORT Contractor

SE SW SW

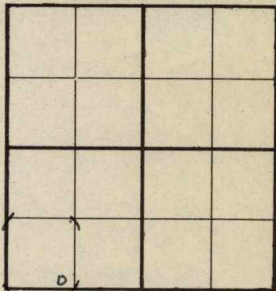SECTION PLAT Ft. from N. Line330 Ft. from S. Line Ft. from E. Line990 Ft. from W. Line**MISCELLANEOUS**Location Rig up

Drilling and Remarks:

Machine

RECORDCased in., ft.Sand Gas Oil Total Depth **PRODUCTION**1st 24 hrs. Nat. 1st 24 hrs. after shot Gas Cu. Ft.Dry Hole Abandoned

Date

APR 2 1941 19

S. J. LEWIS Scout

Map No. 10 Sec. 6 Twp. 27 R. 7EWell No. 1 LindleyChas Johnson etal Company

Contractor

ABANDONED

SECTION PLAT

SE SW SW

 Ft. from N. Line330 Ft. from S. Line Ft. from E. Line990 Ft. from W. Line

MISCELLANEOUS

Location Rig up

Drilling and Remarks:

*KC 2090**5" C 2 1/8"**Water*

RECORD

Cased in., ft.Sand Gas Oil Total Depth 2230

PRODUCTION

1st 24 hrs. Nat. 1st 24 hrs. after shot Gas Cu. Ft.Dry Hole Abandoned

Date

APR 30 1941 19

S. J. LEWIS Scout