


KANSAS
Barton

O.W.D.D

Section 7 Township 18 Range 13-W

Well No. #3 Smith

Company Republic Natural Gas

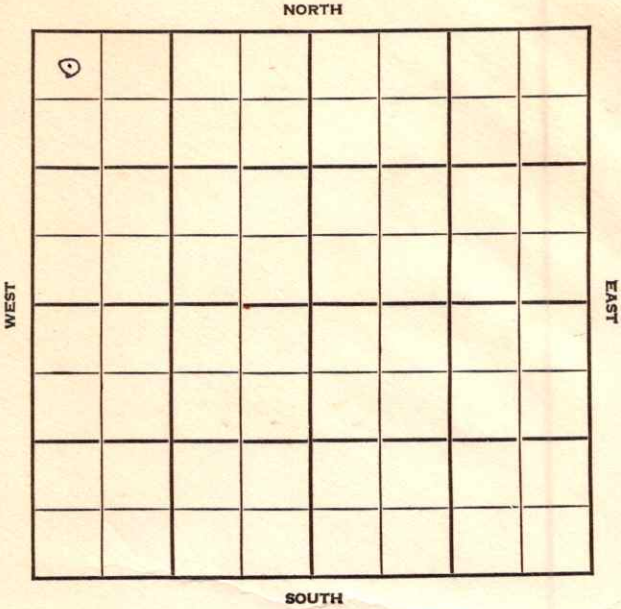

KANSAS

Barton

Sec. 7 Twp. 18 R. 13W

Well No. #3 Smith Farm

Republic Natural Gas Company

Eveleigh Pool **O. W. D. D**


330' Ft. from N. Line

Ft. from S. Line

Ft. from E. Line

330' Ft. from W. Line

NW/C

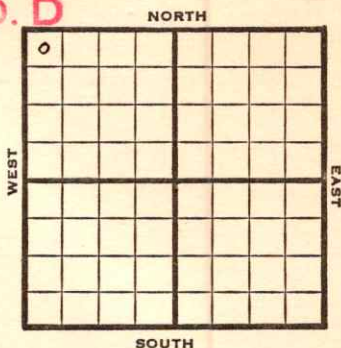

1948

Elev. 1835' REPORT

6/16	Location	
6/23	10" @ 785'	
	Lansing 3090'	
	Drlg 3146'	
6/29	Arbuckle 3321'	
	TD 3330'	
	7" @ 3323'	
	30' oil in 12 hrs.	
7/8	TD 3339'	
	50 shots 3192-3206	
	Swb 1 bbl oil 80% W	
	PH 3000 acid	
7/14	24 shots 3156-65'	
	26 shots 3172-79'	2000 acid 2 W PH
7/21	"	"
7/28	250 acid	
8/4	"	
8/11	"	
8/18	"	
8/25	"	
9/1	"	
9/8	Lans 3090'	Arb 3321'
	7" @ 3323'	TD 3339'
	Perf Lans.	
	1000 acid	
	Pump 12 oil & 25% W Pot.	
	Gr. 36°	

**COMPLETED
OVER**

1950

O. W. D. D

11/29

Arb. 3321'

7" @ 3323'

OTD 3340

Comp. for 21 BOPD 45/3325-40

4 bw 6 goph DD 3347 wtr

DD for SWD

1951

5/2

SWD well TD 3607'

Arb. 3321' 7" @ 3323 OTD 3340'

DD to 3607' for SWD

5" liner @ 3415'

ABANDONED

Map No. _____ Sec. 7 Twp. 18 R. 13W

Well No. 3 Smith

Republic Natural Gas Company

FIRST REPORT

Contractor

NW/C

SECTION PLAT

330 Ft. from N. Line

_____ Ft. from S. Line

_____ Ft. from E. Line

330 Ft. from W. Line

0			

Barton County

Location X

Rig up _____

Drilling and Remarks:

RECORD

Cased _____ in., _____ ft.

Sand _____

Gas _____

Oil _____

Total Depth _____

PRODUCTION

1st 24 hrs. Nat. _____

1st 24 hrs. after shot _____

Gas _____ Cu. Ft.

Dry Hole _____

Abandoned _____

Date

JUN 16 1948 19 _____ S. J. LEWIS Scout

Barton County Kansas StateMap No. 73 Sec. 7 Twp. 18 R. 13WWell No. 3 SmithRepublic Natural Gas CompanyCOMPLETE Contractor

NW/C

E11835
SECTION PLAT330 Ft. from N. Line Ft. from S. Line Ft. from E. Line330 Ft. from W. Line

0							

Eveleigh Pool

Remarks:

Lans 3090

Q23321

7" Q2323

7D3339

Pey Lane

100 acres

Pump 120 ft + 25% W.P.T.

86°-E

Date
SEP 8 1948

Scout S. J. LEWIS

O. W. D. D

County Barton State KansasSec. 7 (Blk.) 18 (Sur.) 13W Map No.Operator Republic Natural GasWell No. 3 Farm SmithElev. 1835 Location T1W NW NW

0							

330 Ft. From N Line NW330 Ft. From W Line Quarter1st. Report NOV 29 1950


Completion

Remarks OWDD for SWD

Spudding Date

Drlg. Data Eveleigh PoolArb. 3321 7" @ 3323 OTD 3340Comp. for 12 bopd 45/ 3325-40 4 bw6 goph DD 3347 water DD for SWD

County Barton State Kansas
 Sec. 7 (Bk.) 18 (Sur.) 13W Map No.
 Operator Republic Natural Gas
 Well No. 3 Farm Smith
 Elev. 1835 Location NW NW NW

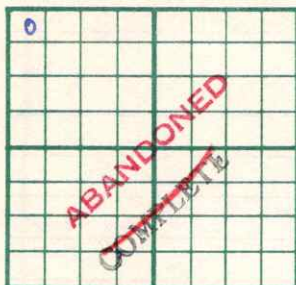

330 Ft. From N Line NW
330 Ft. From W Line Quarter

1st. Report

Completion MAY 2 1951

Remarks OWDD for SWD

O.W.D.D.

Spudding Date

Drlg. Data SWD well TD 3607

Arb. 3321 7" @ 3323 OTD 3340

DD to 3607 for SWD 5" liner @ 3415

J. E. TYRA