

KANSASSection 7 Township 18 Range 13WWell No. 5 SmithCompany Birmingham & Bartlett
Eveleigh

NORTH

WEST

EAST

SOUTH

0

KANSAS

Sec. 7 Twp. 18 R. 13W 

Well No. #5 Smith Farm

Birmingham & Bartlett Company

Eveleigh Pool (B&B, Cont.)

NORTH


990' Ft. from N. Line

Ft. from S. Line

Ft. from E. Line

990' Ft. from W. Line

SE NW SE

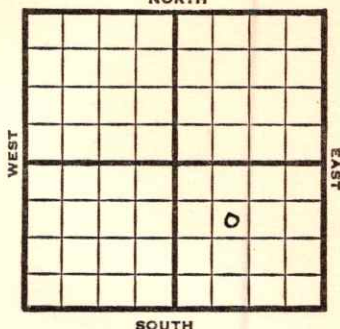

1949

Elev 1849'

REPORT

5/18

8" @ 782'

5/25

Drlg 3292'

6/1

Lans 3112'

Arb. 3331-39'

TD 3339'

5"@ 3332

500 acid

6/8

Arb. 3331'

5"@ 3332'

TD 3339'

500 acid

Pump 265 Oil Pot

36° Gr.

Comp

COMPLETED

Map No. _____ Sec. 7 Twp. 18 R. 13W

Well No. 5 Smith

Birmingham & Bartlett Company

B & B Contractor

SE NW SE


FIRST REPORT
SECTION PLAT

990 Ft. from N. Line

_____ Ft. from S. Line

_____ Ft. from E. Line

990 Ft. from W. Line

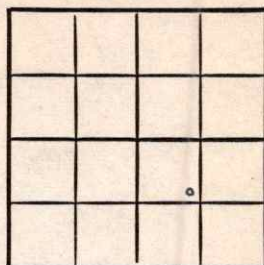

Barton County

Location _____

Rig up _____

Drilling and Remarks:

8" @ 782

RECORD

Cased _____ in., _____ ft.

Sand _____

Gas _____

Oil _____

Total Depth _____

PRODUCTION

1st 24 hrs. Nat. _____

1st 24 hrs. after shot _____

Gas _____ Cu. Ft.

Dry Hole _____

Abandoned _____

Date

MAY 18 1949


19

S. J. LEWIS Scout

Barton County Kansas StateMap No. K73 Sec. 7 Twp. 18 R. 13WWell No. 5 SmithBirmingham & Bartlett Company**COMPLETE**

Contractor

SE NW SE

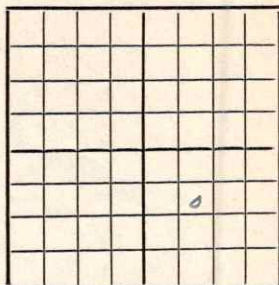E 1,1849**SECTION PLAT**990 Ft. from N. Line Ft. from S. Line Ft. from E. Line990 Ft. from W. Line

Eveleigh Pool

Remarks:

CN 833315' 83332Y 1233395000000Pump 265 oil 1st36°-SDate
JUN 8 1949Scout
S. J. LEWIS