

Section 7 Township 18 Range 13-W


Well No. #5 Smith

Company Republic Natural Gas

NORTH

WEST

EAST

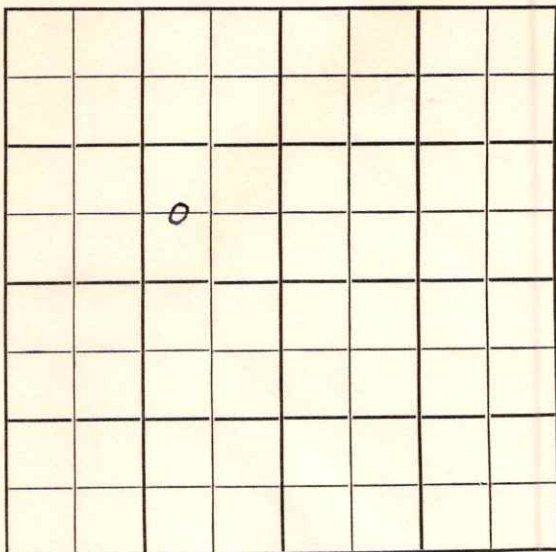

SOUTH

Barton
18

KANSAS

Sec. 7 Twp. 13W R. 13W

Well No. #5 Smith Farm

Republic Natural Gas Company

H & H Drlg. -Contr. Contractor

Eveleigh Pool


Ft. from N. Line

660' Ft. from S. Line

990' Ft. from E. Line

Ft. from W. Line

C W L SE NW

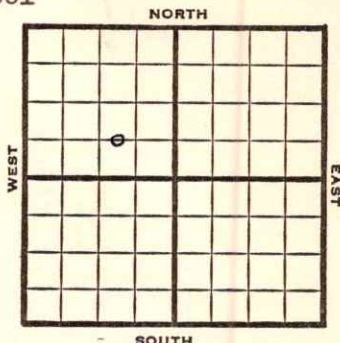

1950

Elev. 1836' REPORT

11/15

Spud 11-11-50

Anhy 770'

10" @ 776'

12/13

Spud 11-11-50

Oil Well TD 3224

Anhy 770'

10" @ 776' Cong. 3301

Arb. 3322-24 7" @ 3323

TD 3324 S/78 bo 9 hr

Lans. 3089'

Comp. 165 bopd

COMPLETED

County Barton State Kansas
 Sec. 7 (Blk.) 18 (Sur.) 13W Map No.
 Operator Republic Natural Gas
 Well No. 5 Farm Smith
 Elev. _____ Location C W L SE NW

FIRST REPORT

660 Ft. From S Line NW
990 Ft. From E Line Quarter

1st. Report NOV 15 1950

Completion _____

Remarks _____


H & H Drlg. - Contr.

Spudding Date 11-11-50

Drlg. Data Eveleigh Pool

Anhy 770 10" @ 776

J. E. TYRA

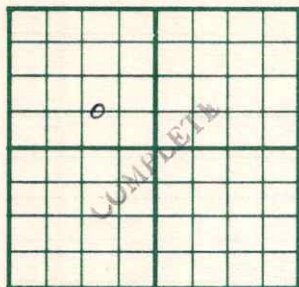County Barton State KansasSec. 7 (Blk.) 18 (Sur.) 13W Map No. (Twp.) (Rge.)Operator Republic Natural GasWell No. 5 Farm SmithElev. 1836 Location C W L SE NW660 Ft. From S Line NW990 Ft. From E Line Quarter

1st. Report

Completion DEC 13 1950Remarks Eveleigh PoolH & H Drlg. - Contr.Spudding Date 11-11-50Drlg. Data Oil well TD 3224Anhy 770 10" @ 776 Cong. 3301Arb. 3322-24 7" @ 3323 TD 3324S/ 78 bo 9 hr. Lans. 3089Comp. 165 bopd