
Butler KANSAS

DX 78-1

Section 6 Township 27 Range 7E

Well No. 1 Huntley

Company Petroleum Inc. Rex & Morris

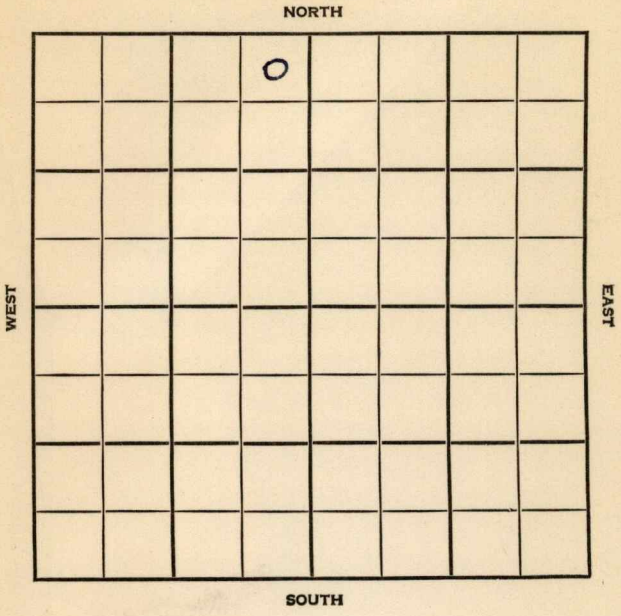

Butler KANSAS

SEC.	TWP.	R.
6	27	7E

WELL NO.

1 Huntley FARM

COMPANY

Petroleum Inc. & Rex & Morris

CONTRACTOR

Rex & Morris


Eckel Pool

330 Ft. from N. Line

Ft. from S. Line

330 Ft. from E. Line

Ft. from W. Line

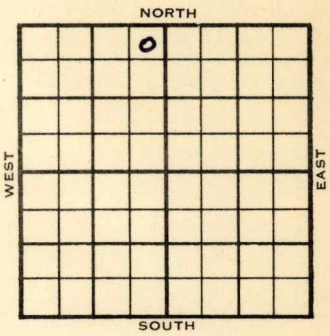

NE NE NW

1954	ELEVATION 1397'	REPORT

7/21 Location

8/25 D & A TD 2761'
8" @ 92 Stal. 1656 Lans. 1730
B. Lans. 1898 KC 2047 B KC 2268
Ft. Scott 2420 Cherokee 2480
Bart 2637 Miss. 2718
TD 2761 D & A

ABANDONED

DX-78

FORM 275 FOR SALE BY KANSAS BLUE PRINT CO.

County Butler State Kansas

Sec. 6 (Blk. Twp.) 27 (Sur. Rge.) 7E Map No.

Operator Petroleum Inc. & Rex & Morris

Well No. 1 Farm Huntley

Elev. Location NE NE NW



330 Ft. From N Line NW

330 Ft. From E Line Quarter

1st. Report JUL 21 1954

Completion

Remarks Rex & Morris - Contr.

Spudding Date

Drlg. Data Eckel Pool

Location

J. G. McGEHEE

FORM 275 FOR SALE BY KANSAS BLUE PRINT CO.

County Butler State Kansas

Sec. 6 (Blk. Twp.) 27 (Sur. Rge.) 7E Map No.

Operator Petroleum Inc, & Rex & Morris

Well No. 1 Farm Huntley

Elev. 1397 Location NE NE NW



330 Ft. From N Line NW

330 Ft. From E Line Quarter

1st. Report

Completion AUG 25 1954

Remarks Eckel Pool

Rex & Morris - Contr.

Spudding Date

Drlg. Data D & A TD 2761

8" @ 92 Stal. 1656 Lans. 1730

B. Lans. 1898 KC 2047 B KC 2268

Ft. Scott 2420 Cherokee 2480 Bart. 2637

Miss. 2718 TD 2761

D & A

FABEN GILSTRAP