
FORM 51 10M 2-49 PETROL KANSAS Barton Co.

Section 7 Township 18 Range 13W

Well No. #6 Smith

Company Birningham & Bartlett

Eveleigh pool

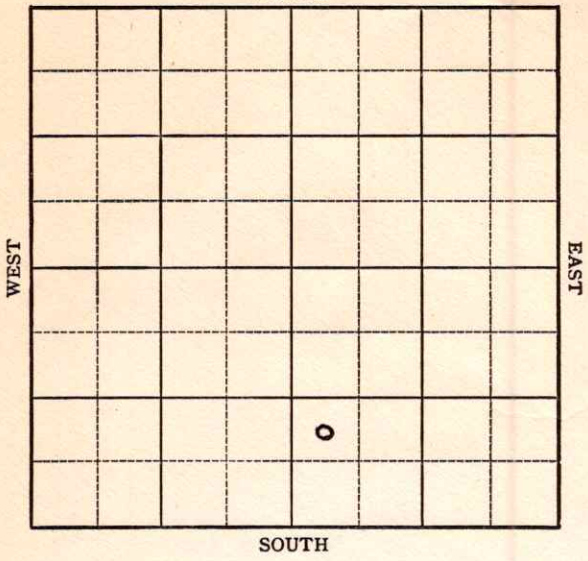

FORM 252-A
5M 10-48 PETROL

Barton KANSAS

Sec. 7 Twp. 18 R. 13W

Well No. #6 Smith Farm

Birmingham & Bartlett Company

Eveleigh (Birmingham & Bartlett Cont.)
Pool


_____ Ft. from N. Line

990' Ft. from S. Line

_____ Ft. from E. Line

330' Ft. from W. Line

NW SW SE

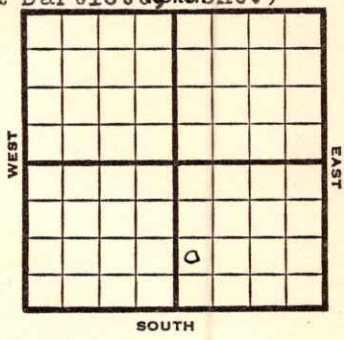

1949	Elev. 1852' REPORT
8/17	Anhy 781' 8" @ 787'
8/24	Drlg. 3290'
8/31	Arbuckle 3241' 5" @ 3243' Drlg. 3257'
9/7	Arb 3241' 5" @ 3243' 500 acid TD 3358' ABANDONED

Form 26 200 Bks. 6-49 Petrol

Kansas

Eveleigh Pool

Map No. _____ Sec. 7 Twp. 18 R. 13W

Well No. 6 Smith


Birmingham & Bartlett Company

Birmingham & Bartlett Contractor

NW SW SE

FIRST REPORT

SECTION PLAT

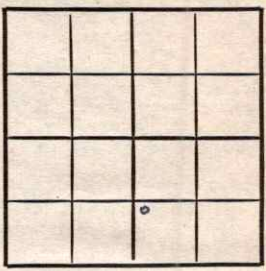

_____ Ft. from N. Line

990 Ft. from S. Line

_____ Ft. from E. Line

330 Ft. from W. Line

Barton County

Location _____

Rig up _____

Drilling and Remarks:

Anhy 781

8" @ 787

RECORD

Cased _____ in., _____ ft.

Sand _____

Gas _____

Oil _____

Total Depth _____

PRODUCTION

1st 24 hrs. Nat. _____

1st 24 hrs. after shot _____

Gas _____ Cu. Ft.

Dry Hole _____

Abandoned _____

Date

AUG 17 1949 19 S. J. LEWIS Scout

Form 26 200 Bks. 6-49 Petrol

Kansas

Eveleigh Pool

Map No. K23 Sec. 7 Twp. 18 R. 13W

Well No. 6 Smith


Birmingham & Bartlett Company

ABANDONED Contractor

NW SW SE

E 1/2 1852

SECTION PLAT

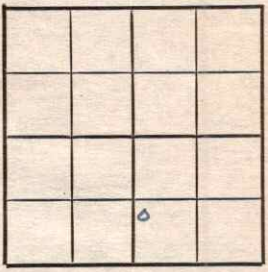

____ Ft. from N. Line

990 Ft. from S. Line

____ Ft. from E. Line

330 Ft. from W. Line

Barton County

Location

Rig up

Drilling and Remarks:

Cir 3241

5" @ 3243

500 acid

RECORD

Cased ____ in., ____ ft.

Sand

Gas

Oil

Total Depth 3255'

PRODUCTION

1st 24 hrs. Nat.

1st 24 hrs. after shot

Gas ____ Cu. Ft.

Dry Hole

Abandoned

Date

SEP 7 1949

19

S. J. LEWIS Scout