


Map No. **KANSAS** Sec. *15* Twp. *26* R. *2E*

Well No. *8-R Lygusse* Farm

Shell Pipe Company

NORTH

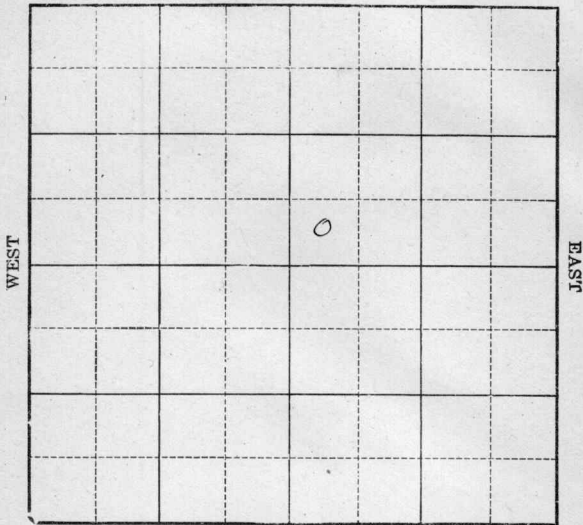

SOUTH

Location _____

Drilling Remarks _____

Rig Up _____

Drilling Remarks _____

RECORD

Cased _____ in. _____ ft.

Sand _____

Gas _____

Oil _____

Total Depth _____

PRODUCTION

1st 24 hrs. Nat. _____

1st 24 hrs. after shot _____

Gas _____ cu. ft.

Dry Hole _____


Abandoned _____

Suppwick

Map No. *KANSAS* Sec. *15* Twp. *26* R. *2E*

Well No. *8-A Lygrisse* Farm
Shell *PLT* Company

_____ Ft. from N. Line
330 Ft. from S. Line
 _____ Ft. from E. Line
330 Ft. from W. Line
1930

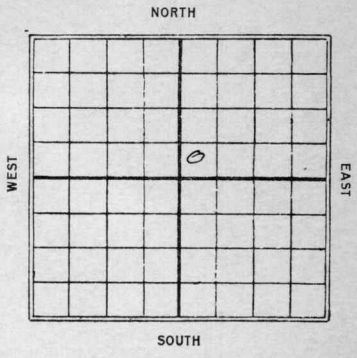

Date REPORT

| Date | REPORT |
|--------------|----------------------------------|
| <i>7/9</i> | <i>Loc</i> |
| <i>7/16</i> | <i>Rig</i> |
| <i>7/23</i> | <i>hdlg. 1573'</i> |
| <i>7/30</i> | <i>" 2875'</i> |
| <i>8/6</i> | <i>Rust 2875'</i> |
| <i>8/13</i> | <i>—</i> |
| <i>8/20</i> | <i>—</i> |
| <i>8/27</i> | <i>hdlg. 2927'</i> |
| <i>9/3</i> | <i>" 2995'</i> |
| <i>9/10</i> | <i>Top Chat 3017 V/R 8"</i> |
| <i>9/17</i> | <i>Dry 3023</i> |
| <i>9/24</i> | <i>7" - 3042</i> |
| | <i>Dry 3045'</i> |
| <i>10/1</i> | <i>Top Chat 3053'</i> |
| | <i>Show oil & water</i> |
| | <i>hdlg. 3068 "77W"</i> |
| <i>10/8</i> | <i>SID. 3077 T.D.</i> |
| <i>10/15</i> | <i>T.D. 3068</i> |
| | <i>dry & Abandon</i> |

Map No. 13 **KANSAS** Sec. 15 Twp. 26 R. 2E

Well No. J-A Lygwise

Chas. W. Pe. J. Company

Contractor

SECTION PLAT

..... Ft. from N. Line

230 Ft. from S. Line

..... Ft. from E. Line

230 Ft. from W. Line

| | | | |
|--|--|---|--|
| | | | |
| | | | |
| | | 0 | |
| | | | |
| | | | |

FIRST REPORTS

Location ✓.....

Rig up.....

Drilling and Remarks:

RECORD

Cased..... in., ft.

Sand.....

Gas.....

Oil.....

Total Depth.....

PRODUCTION

1st 24 hrs. Nat.....

1st 24 hrs. after shot.....

Gas..... Cu. Ft.

Dry Hole.....

Abandoned.....

Date

JUL 9 1930

192.....

S. J. LEWIS Scout

Map No. KANSAS Sec. 15 Twp. 26 R. 27

Well No. 8 A Lygriess

Shepherd Company

Contractor

SECTION PLAT

..... Ft. from N. Line

330 Ft. from S. Line

..... Ft. from E. Line

330 Ft. from W. Line



ABANDONED

Location.....

Rig up.....

Drilling and Remarks:

RECORD

Cased..... in., ft.

Sand.....

Gas.....

Oil.....

Total Depth 3068

PRODUCTION

1st 24 hrs. Nat.....

1st 24 hrs. after shot.....

Gas..... Cu. Ft.

Dry Hole.....

Abandoned.....

Date

OCT 15 1930
..... 192

S. J. LEWIS Scout