

Section 7 Township 18 Range 13 WWell No. # 2 W. O. SmithCompany Pacific Western

NORTH

SOUTH

WEST

EAST

Handwritten marks: "OK" and a circled "X" in the 6th row, 6th column.

Barton

KANSAS

SEC.	TWP.	R.
7	18	13 W
WELL NO.		
# 2 W. O. Smith		
COMPANY		FARM
Pacific-Western		
CONTRACTOR		


_____ Ft. from N. Line

330 _____ Ft. from S. Line

~~990~~ _____ Ft. from E. Line

~~990~~ _____ Ft. from W. Line

~~SE SW NE~~
~~SW SE NE~~

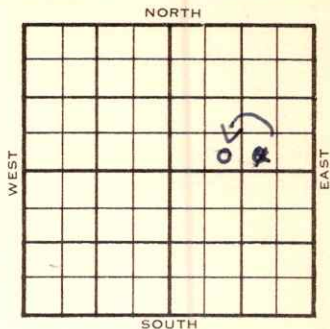

	ELEVATION	REPORT
1953	1833'	
11/24	MIR	
12/9	8" @ 772 w/450	Heeb 3012 Tor. 3023 Doug. 3038 Br li 3090 Lans. 3104 DST 3094-3148, 1 hr, 10' M 30#
12/16	Arb. 3325 RTD 3328 5" @ 3326 DD 3329' TD S/9 BO 11 hr. 250A S/7 BO 6 hrs.	
1954		
1/6	Spud 11-24-53 Oil well TD 3339 8" @ 772 Heeb 3012 Tor. 3023 Doug. 3038 Br. lime 3090 Lans. 3104' DST 3094-3148 open 1 hr rec 10' mud 30# Arb. 3325 TD 3328 5" @ 3326 DD 3329 S/9 BO 11 hr. 250 A S/7 BO 6 hr. DD 3339 S/3 BO 34 BW 3 hr. SP 3334 3 1/2 BO 3 hr. P/36 BO 24 hr. Comp. 41 BOPD 1 BW	

COMPLETED

County **Barton** State **Kansas**

Sec. 7 (Blk.) (Sur.)
(Twp.) 18 (Rge.) 13W Map No.

Operator Pacific-Western

Well No. 2 Farm W. O. Smith

Elev.	Location	SW	SE	NE

330 Ft. From S Line NE

990 Ft. From E Line Quarter

1st. Report NOV 24 1953

Completion

Remarks

Spudding Date _____

Drlg. Data

MIR

J. G. McGEHEE

Kadsai

Map No. _____ Sec. 7 Twp. 18 R. 13WWell No. 2 W. O. SmithPacific Western CompanyCORRECTION Contractor

SE SW NE

SECTION PLAT

_____ Ft. from N. Line

330 Ft. from S. Line

_____ Ft. from E. Line

990 Ft. from W. LineBarton County

Location _____

Rig up _____

Drilling and Remarks:

Reported

SW SE NE

RECORD

Cased _____ in., _____ ft.

Sand _____

Gas _____

Oil _____

Total Depth _____

PRODUCTION

1st 24 hrs. Nat. _____

1st 24 hrs. after shot _____

Gas _____ Cu. Ft.


Dry Hole _____

Abandoned _____

Date

DEC 2 1953 19J. G. McGEHEE Scout

County Barton State Kansas
 Sec. 7 (Blk. 18 (Sur. 13W Map No.
 (Twp. (Rge.)
 Operator Pacific-Western
 Well No. 2 Farm W. O. Smith
 Elev. 1833 Location SE SW NE

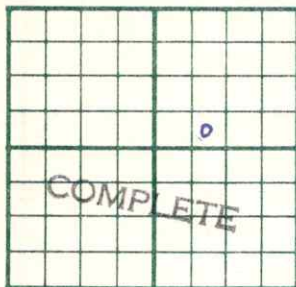

330 Ft. From S Line NE
 990 Ft. From W Line Quarter

1st. Report

Completion JAN 6 1954

Remarks

Spudding Date 11-24-53

Drlg. Data Oil well TD 3339

8" @ 772 Heeb. 3012 Tor. 3023

Doug. 3038 Br. lime 3090 Lans. 3104

DST 3094-3148 open 1 hr. Rec. 10' mud

30# Arb. 3325 TD 3328 5" @ 3326

DD 3329 S/ 9 bo 11 hr. 250 A

S/ 7 bo 6 hr. DD 3339 S/ 3 bo 34 bw

3 hr. SP 3334 3½ bo 3 hr.

P/ 36 bo 24 hr. Comp. 41 hopd 1 bw

J. G. McGEHEE