

Section 8 Township 18 Range 13 WWell No. # 1 BoomhowerCompany Nadel & Gussman

NORTH

WEST

		0					

EAST

SOUTH

Barton KANSAS

SEC. 8 TWP. 18 R. 13W ✓

WELL NO.

1 Boomhower FARM

Nadel & Gussman

CONTRACTOR


Reserve Drlg.

Ft. from N. Line

330 Ft. from S. Line

990 Ft. from E. Line

Ft. from W. Line

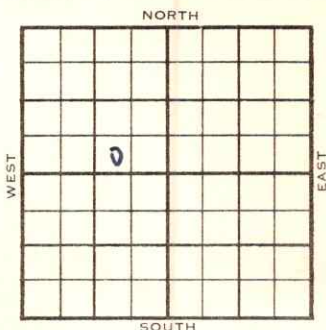

SW SE NW


	ELEVATION	REPORT
1954	1823'	

5/12	RUR
5/19	8" @ 769 Drlg. 2368
5/26	Heeb 2998 Br. li 3079 KC 3096 DST 3215-26, 1 hr, 15' M O# Arb. 3316 TD 3319' 5" @ 3316
6/2	NR
6/15	Spud 5-11-54 D&A TD 3321' 8" @ 769' Heeb 2998', Br lime 3079', KC 3096' DST 3215-26', opn 1 hr., rec. 15' mud O# Arb. 3316' TD 3319' 5" @ 3316' CO to 3319' 5 15' goph 500A DD 3321, CO to 3319, FU 15' gf 12 hrs. 9/3316-19, 500A, 7½ bfph 85% wtr. D&A

ABANDONED

J. G. McGEHEE

County Barton State Kansas
 Sec. 8 (Blk.) 18 (Sur.) 13W Map No. _____
 Operator Nadel & Gussman
 Well No. 1 Farm Boomhower
 Elev. 1823 Location SW SE NW

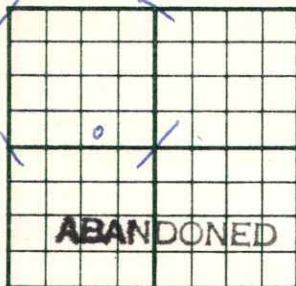

330 Ft. From S Line NW
990 Ft. From E Line Quarter

1st. Report

Completion

JUN 1 1954

Remarks

Reserve D₁g. - Contr.

Spudding Date 5-11-54

Drlg. Data D & A TD 3321

8" @ 769 H_eeb. 2998 Br. lime 3079

KC 3096 DST 3215-26 open 1 hr. Rec.

15' mud 0# Arb. 3316 TD 3319

5" @ 3316 CO to 3319 15 goph 500 A

DD 3321 CO to 3319 FU 15 gf 12 hr.

9/ 3316-19 500 A 7 $\frac{1}{2}$ bfph 85% wtr.

D. & A.