


KANSAS

Map No. _____ Sec. 6 Twp. 27 R. 7

Well No. 1- Hunterley Farm
Shawver et al Company

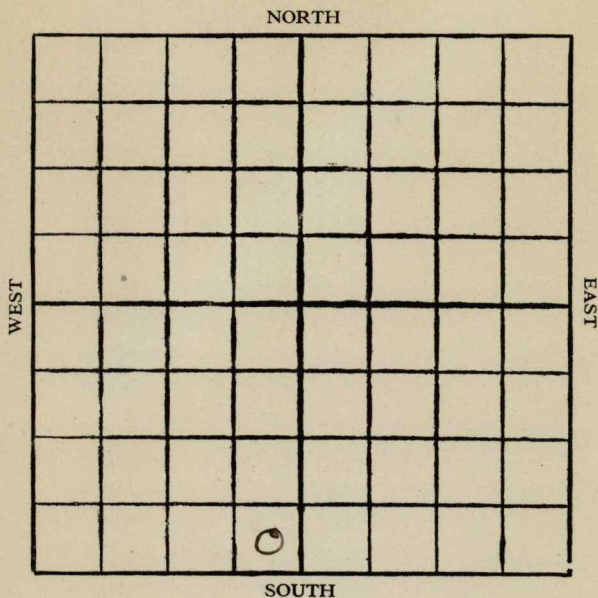

Location

Drilling Remarks

.....

.....

RECORD

Cased in. ft.

Sand

Gas

Oil

Total Depth

Rig Up

Drilling Remarks

.....

.....

PRODUCTION

1st 24 hrs. Nat.

1st 24 hrs. after shot

Gas cu. ft.

Dry Hole

Abandoned

Map No. **KANSAS** Sec. 6 Twp. 27 R. 7
 Well No. 1 - Huntley Farm
Shawver et al Company

NORTH

Ft. from N. Line

330 Ft. from S. Line330 Ft. from E. Line

Ft. from W. Line

WEST

EAST

SOUTH

1928

Date

REPORT

5/31 Spudding
6/7 Spudding 300'
6/14 Drilling 1100
6/21 " 1800
6/28 show oil 2194
 L. + d. 2308

KANSAS

MAP NO. _____ SEC. 6 TWP. 27 R. 6

WELL NO. 1 Huntley

Shawver et al

COMPANY

CONTRACTOR

SECTION PLAT

FIRST REPORTS

_____ FT. FROM N. LINE

330

_____ FT. FROM S. LINE

330

_____ FT. FROM E. LINE

_____ FT. FROM W. LINE

Correct to 6-27-7

RECORD

LOCATION _____

CASED _____ IN. _____ FT.

RIG UP _____

SAND _____

DRILLING AND REMARKS:

GAS _____

OIL _____

TOTAL DEPTH _____

PRODUCTION

1ST 24 HRS. NAT. _____

1ST 24 HRS. AFTER SHOT _____

GAS _____ CU. FT.

DRY HOLE _____

ABANDONED _____

DATE

MAY 31 1928

CHAS. L. SHERWOOD

192

SCOUT

Butler

10 KANSAS
MAP NO. _____ SEC. 6 TWP. 27 R. 7WELL NO. 1 Huntley
Shawver et al

COMPANY

CONTRACTOR

CORRECTION

SECTION PLAT

_____ FT. FROM N. LINE

330

_____ FT. FROM S. LINE

330

_____ FT. FROM E. LINE

_____ FT. FROM W. LINE

LOCATION _____

RIG UP _____

DRILLING AND REMARKS:

Previously
reported in log &
6- chg to log 7.

RECORD

CASED _____ IN. _____ FT.

SAND _____

GAS _____

OIL _____

TOTAL DEPTH _____

PRODUCTION

1ST 24 HRS. NAT. _____

1ST 24 HRS. AFTER SHOT _____

GAS _____ CU. FT.

DRY HOLE _____

ABANDONED _____

DATE

JUN

7 1928

CHAS. L. SHERWOOD

192

SCOUT

Butler

K10 KANSAS
Map No. _____ Sec. 6 Twp. 27 R. 7
Well No. 1 Huntley
Shawover et al Company

Contractor

COMPLETED

SECTION PLAT

_____ Ft. from N. Line
330 _____ Ft. from S. Line
330 _____ Ft. from E. Line
_____ Ft. from W. Line

ABANDONED

Location _____
Rig up _____
Drilling and Remarks:

Show oil 7194'

RECORD

Cased _____ in., _____ ft.
Sand _____
Gas _____
Oil _____
Total Depth 7308

DDG 7308

PRODUCTION

1st 24 hrs. Nat. _____
1st 24 hrs. after shot _____
Gas _____ Cu. Ft.
Dry Hole ✓
Abandoned _____