


Hedrick
Map No. KANSAS Sec. 15 Twp. 26 R. 2E
Well No. B-1 Jygrisse Farm
Shell Pet Company

NORTH

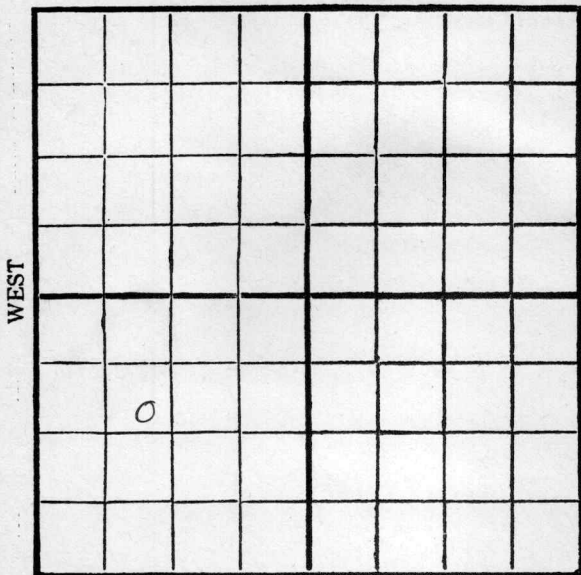

SOUTH

Location _____
Drilling Remarks _____

Rig Up _____
Drilling Remarks _____

RECORD

Cased _____ in. _____ ft.
Sand _____
Gas _____
Oil _____
Total Depth _____

PRODUCTION

1st 24 hrs. Nat. _____
1st 24 hrs. after shot _____
Gas _____ cu. ft. _____
Dry Hole _____
Abandoned _____

Map No. KANSAS Sec. 15 Twp. 26 R. 2E


Well No. B-1 Lygrisse Farm
Shell Pitt Company

1112 Ft. from N. Line

_____ Ft. from S. Line

_____ Ft. from E. Line

1177 Ft. from W. Line

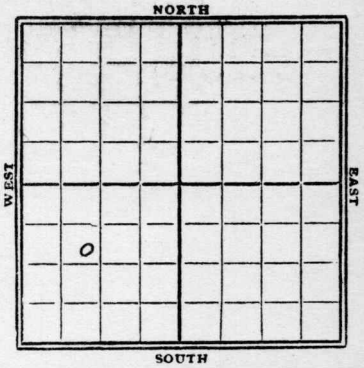

1929

| Date | REPORT |
|------|--------|
|------|--------|

| | |
|------|-----------------------|
| 7/24 | Bldg Rig |
| 7/31 | Rig up |
| 8/7 | Drlg 1855' |
| 8/14 | " 2861 |
| 8/21 | Chat 2892-95 H. J. O. |
| 8/28 | Chat 2892-95' |
| | T.D. 2895' |
| | swab 841 bbl oil |
| | Comp. |

Map No. 13 **KANSAS** Sec. 15 Twp. 26 R. 2E

Well No. B-1 Lygriess

Shell Oil Company

Contractor

SECTION PLAT

1112 Ft. from N. Line

..... Ft. from S. Line

..... Ft. from E. Line

1177 Ft. from W. Line

| | | | |
|--|--|--|--|
| | | | |
| | | | |
| | | | |
| | | | |
| | | | |

FIRST REPORTS

Location.....

Rig up.....

Drilling and Remarks:

Building rig

RECORD

Cased..... in., ft.

Sand.....

Gas.....

Oil.....

Total Depth.....

PRODUCTION

1st 24 hrs. Nat.....

1st 24 hrs. after shot.....

Gas..... Cu. Ft.

Dry Hole.....

Abandoned.....

Date

JUL 24 1929

192.....

S. J. LEWIS

Scout

Map No. *KANSAS* Sec. *15* Twp. *26* R. *25*

Well No. *B-1 Ingrise*

She U. R. & O. Corp Company

Contractor


SECTION PLAT

1112 Ft. from N. Line

..... Ft. from S. Line

..... Ft. from E. Line

1117 Ft. from W. Line

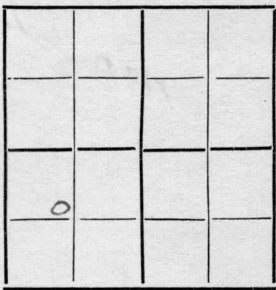

COMPLETED

Location.....

Rig up.....

Drilling and Remarks:

Chat 2892-95

Swat 84/88

RECORD

Cased.....in.,ft.

Sand.....

Gas.....

Oil.....

Total Depth *2895*

PRODUCTION

1st 24 hrs. Nat.....

1st 24 hrs. after shot.....

Gas.....Cu. Ft.

Dry Hole.....

Abandoned.....

Date

AUG 28 1929

192.....

S. J. LEWIS

Scout