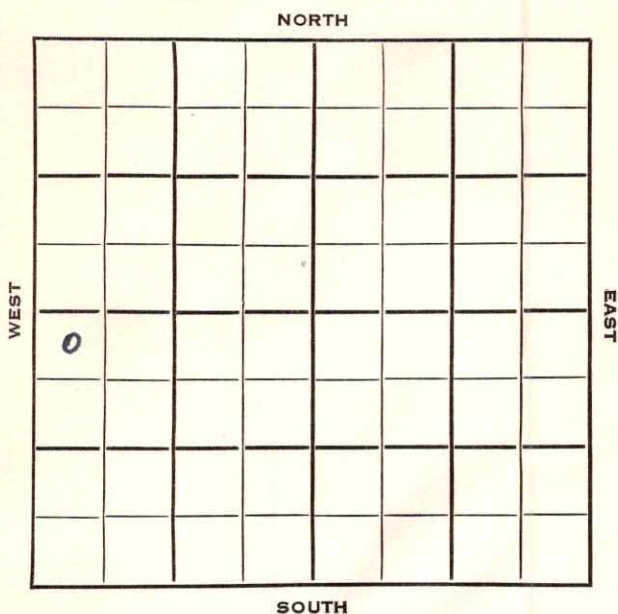


Section 8 Township 18 Range 13 WWell No. # 4 ReidelCompany Honaker Drlg.

Barton

KANSAS

SEC.	TWP.	R.
8	18	13W

WELL NO.

4 Reidel

FARM

COMPANY

Honaker Drlg.

CONTRACTOR

Honaker Drlg.

330

Ft. from N. Line


Ft. from S. Line

Ft. from E. Line

330

Ft. from W. Line

NW NW SW

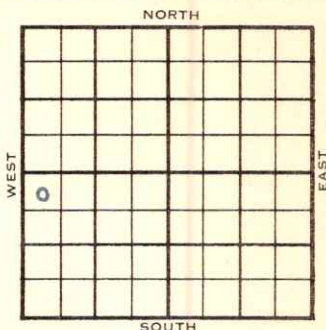

1953

ELEVATION

1824'

REPORT

9/9

Spud 9-4-53

Anhy 767'

8" @ 770

Drlg. 1730'

9/16

Heeb 2991, Br 11 3070, Lans 3086

DST 3131-77, 1 h.r., 95' SW

DST 3207-31, 1 hrs., 120' OCM,
540' free oil, 930#

DST 3237-80, 1/2 hrs., 10' m,

Arb. 3306

RTD 3309

5" @ 3309'

9/23

NR

10/7

CO 3309' 1 BOPH DD 3010 300 A

S/2-3/4 BOPH 4 hrs.

10/14

NR

10/21

Spud 9-4-53 Oil well TD 3010

Anhy 767' 8" @ 770 Heeb 2991

Br lime 3070 Lans 3086

DST 3131-77 open 1 hr rec 95' SW
75#DST 3207-31 open 1 hr rec 120' OCM,
540' free oil, 930#

DST 3237-80 open 1/2 hr, rec 10' mud. 0#

OVER

1953

10/21

(Information continued)

Arb. 3306' TD 3309'

5" @ 3309 CO to 3309 1 BOPH

DD 3010' 300 A S/2-3/4 BOPH 4 hr.

Comp. 258 BOPD

COMPLETED

J. G. McGEHEE