

Barton


KANSAS

FORM 51

Section 8 Township 18 Range 13W

Well No. #3 F. Reidel

Company Honaker Drlg. Co

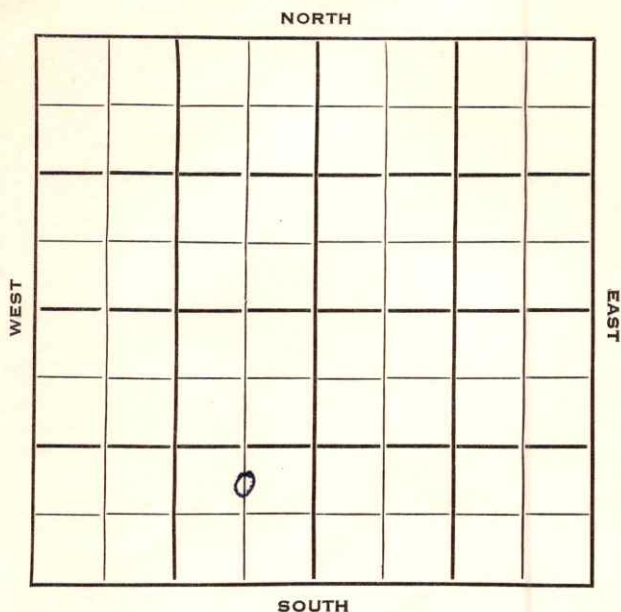

Barton

KANSAS

Sec. 8 Twp. 18 R. 13W

Well No. #3 F. Reidel Farm

Honaker Drlg. Co. Company

Kiefer & Frause Contractor

Eveleigh Pool


Ft. from N. Line

990 Ft. from S. Line

660 Ft. from E. Line

Ft. from W. Line

C N/2 SE SW

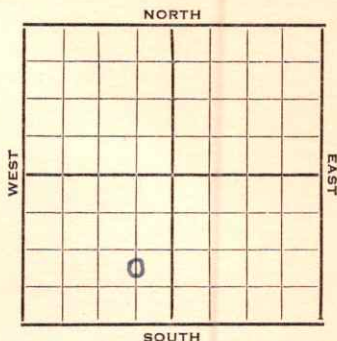


1953 Elev. 1822' REPORT

7/8 Spud 7-3-53
8" @ 749
Drlg. 1486'

7/22 NR

8/5 Spud 7-3-53
Oil Well
TD 3304'
8" @ 749'
Anhy 744, Heeb 2982, Br. Lime 3062,
KC 3077,
DST 3164-78 opn $\frac{1}{2}$ hr, rec 12' mud 880#
DST 3203-15 opn $\frac{3}{4}$ hr, rec 25' mud
VSSO 90#
DST 3217-45 opn 1 hr, rec 65' wcm
Arb 3301
TD 3303'
5" @ 3302'
CO to 3303'
FU 800' oil 55 min
DD 3304' FU 2300' oil 7 hr.
500 A S/ 26 boph
Comp. 427 bopd.

COMPLETED

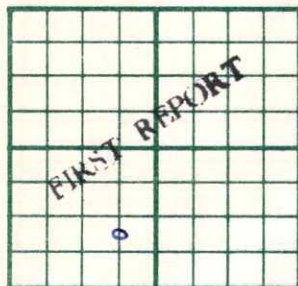County Barton State KansasSec. 8 (Blk.) 18 (Sur.) 13W Map No.Operator Honaker Drilling Co.Well No. 3 Farm F. ReidelElev. Location C N/2 SE SW990 Ft. From S Line SW660 Ft. From E Line Quarter1st. Report JUL 8 1953

Completion

Remarks

Kiefer & Frause - Contr.Spudding Date 7-3-53Drlg. Data Eveleigh pool8" @ 749 Drlg. 1486

J. G. McGEHEE

County Barton State Kansas
 Sec. 8 (Blk.) 18 (Sur.) 13W Map No.
 Operator Honaker Drilling
 Well No. 3 Farm F. Reidel
 Elev. 1822 Location C N L SE SW



990 Ft. From S Line SW
660 Ft. From E Line Quarter

1st. Report

Completion AUG 5 1953

Remarks Eveleigh Pool

Kiefer & Frause - Contr.

Spudding Date 7-3-53

Drlg. Data Oil well TD 3304
8" @ 749 Anhy 744 Heeb. 2982
Br. lime 3062 KC 3077 DST 3164-78
open $\frac{1}{2}$ hr. Rec. 12' mud 880#
DST 3203-15 open $\frac{3}{4}$ hr. Rec. 25' mud
VSSO 90# DST 3217-45 open 1 hr.
Rec. 65' wcm 580# Arb. 3301 TD 3303
5" @ 3302 CO to 3303 FU 800' oil
55 min. DD 3304 FU 2300' oil 7 hr.
500 A S/ 26 boph Comp. 427 bopd

J. G. McGEHEE