

Barton

DX 78-1

KANSAS

Section 8 Township 18 Range 13W

Well No. #5 Riedel

Company Heathman & Seeligson

NORTH

WEST

EAST

6

SOUTH

SEC.	TWP.	R.
8	18	13W

WELL NO.

5 Riedel

FARM

COMPANY

Heathman & Seeligson

CONTRACTOR

60. Tools

Eveleigh Pool

Ft. from N. Line


330

Ft. from S. Line

330

Ft. from E. Line

Ft. from W. Line

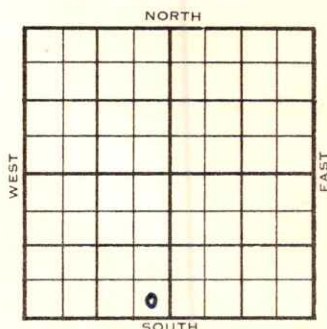

SE SE SW

1954

ELEVATION

1817'

REPORT

5/5

Spud 4-28-54
 8" @ 750'
 Drlg. 2225'

5/13

Heeb 2979', Br li 3062', Lans 3077'
 DST 3156-73', 1 hr., 11' m, 50#
 DST 3205-23', 1 hr., 265' gas, 35'
 SOCM, 150#
 Arb. 3301'
 RTD 3303' Schl

5/19

5" @ 3302 CO 3303 S/1 BOPH
 DD 3305' TD S/5 BOPH 8 hrs. 500 A
 S/20 BOPH 2 hrs.

5/26

Spud 4-28-54
 Oil Well
 TD 3305'
 8" @ 750'
 Heeb 2979', Br lime 3062', Lans 3077'
 DST 3156-73', opn 1 hr., rec. 11' mud,
 50#
 DST 3205-23', opn 1 hr., rec. 265'
 gas, 35' socm, 150#
 Arb. 3301'
 TD 3303'
 5" @ 3302'
 DD 3305', S/5 boph 8 hrs., 500A, S/
 20 boph 2 hrs. - Comp 428 bopd

J. G. McGEHEE

County Barton State Kansas
 Sec. 8 (Blk.) 18 (Sur.) 13W Map No.
 Operator Heathman & Seeligson
 Well No. 5 Farm Riedel
 Elev. 1817 Location SE SE SW



330 Ft. From S Line SW

330 Ft. From E Line Quarter

1st. Report

Completion MAY 26 1954

Remarks Eveleigh Pool

Co. tools

Spudding Date 4-28-54

Drlg. Data Oil well TD 3305

8" @ 750 Heeb. 2979 Br. lime 3062

Lans. 3077 DST 3156-73 open 1 hr.

Rec. 11' mud 50# DST 3205-23

open 1 hr. Rec. 265' gas 35' socm

150# Arb. 3301 TD 3303 5" @ 3302

DD 3305 S/ 5 boph 8 hr. 500 A

S/ 20 boph 2 hr. Comp. 428 bopd

J. G. McGEHEE