


Stedman
Map No. KANSAS Sec. 15 Twp. 26 R. 2E
Well No. B-2 Lyness Farm
Phillips Company

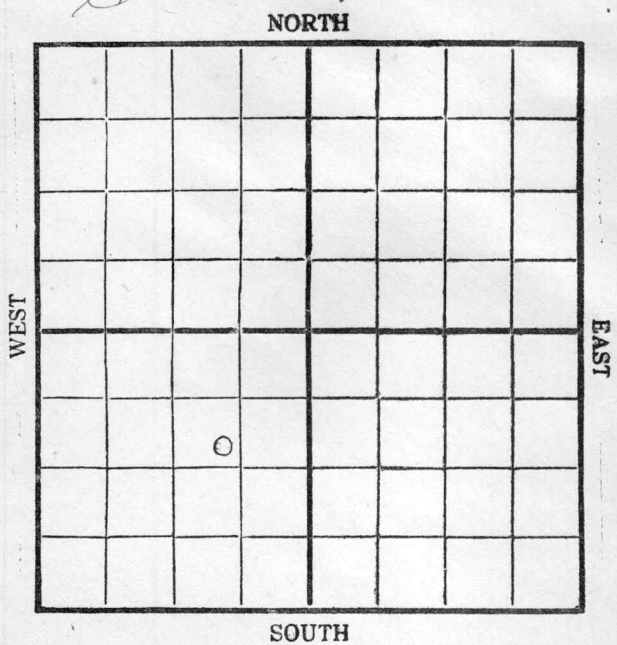

Location _____
Drilling Remarks _____

Rig Up _____
Drilling Remarks _____

RECORD


Cased _____ in. _____ ft.
Sand _____
Gas _____
Oil _____
Total Depth _____

PRODUCTION

1st 24 hrs. Nat. _____
1st 24 hrs. after shot _____
Gas _____ cu. ft.
Dry Hole _____
Abandoned _____

Map No. KANSAS Sec. 15 Twp. 26 R. 2E
Well No. B-2 Lygrisse Farm
Skull Pit Company

1145 Ft. from N. Line
_____ Ft. from S. Line
800 Ft. from E. Line
_____ Ft. from W. Line

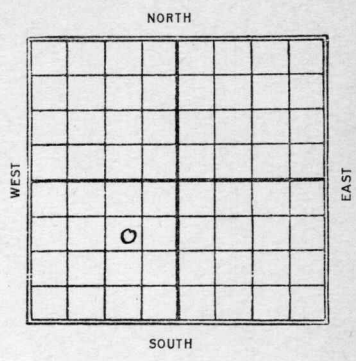

1929

Date	REPORT
9/4	Rig (rotary)
9/11	Shut
9/18	2892045'
9/25	" 28849
10/2	Top chat 2889 T.D. 2893' H.F. oil
10/9	chat 2889-94' T.D. 2894 swab 205 bbl oil 20 " water Comp.

Map No. KANSAS Sec. 15 Twp. 26 R. 2E

Well No. B-2 Lygriess

Shell Co. Company

Contractor

SECTION PLAT

	0		

1145 Ft. from N. Line

..... Ft. from S. Line

800 Ft. from E. Line

..... Ft. from W. Line

FIRST REPORTS

Location.....

Rig up.....

Drilling and Remarks:

RECORD

Cased..... in., ... ft.

Sand.....

Gas.....

Oil.....

Total Depth.....

PRODUCTION

1st 24 hrs. Nat.....

1st 24 hrs. after shot.....

Gas..... Cu. Ft.

Dry Hole.....

Abandoned.....

Date

SEP 4 1929

192

S. J. LEWIS

Scout

Geolowich
 Map No. KANSAS Sec. 15 Twp 26 R. 25

Well No. B-2 Lygrosse

Brill & Co. Company

Contractor

SECTION PLAT

	0		

1145 Ft. from N. Line

..... Ft. from S. Line

800 Ft. from E. Line

..... Ft. from W. Line

COMPLETED

Location.....

Rig up.....

Drilling and Remarks:

Chas 2889-94

Boat 200 ft hole

20 ft water

RECORD

Cased.....in., ...ft.

Sand.....

Gas.....

Oil.....

Total Depth 2894

PRODUCTION

1st 24 hrs. Nat.....

1st 24 hrs. after shot.....

Gas.....Cu. Ft.

Dry Hole.....

Abandoned.....

Date

OCT 9 1929

192

S. J. LEWIS

Scout