
FORM 51 10M 8-47

KANSAS Barton

Section 8 Township 18 Range ~~11W~~

Well No. #1 Dalziel

Company ~~United Pet~~ Henderson Oil
Wildcat

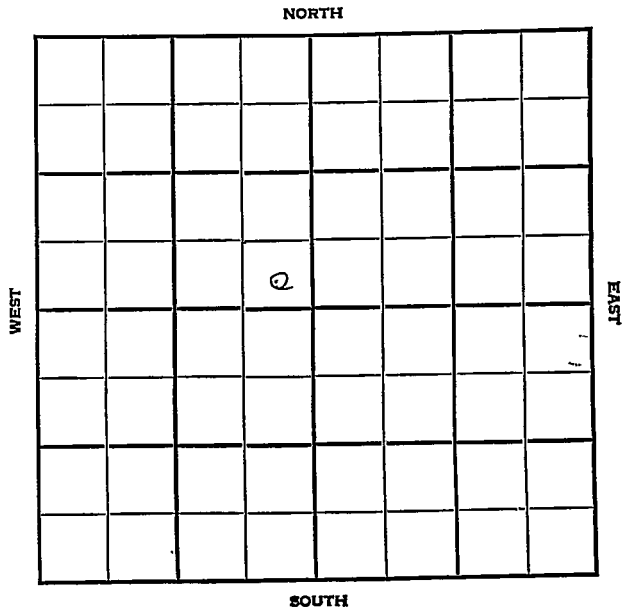

O.W.W.O.

FORM 252-A
5M 12-45 PETROL


KANSAS Barton ✓

Sec. 8 Twp. 18 R. 11W

Well No. #1 Dalziel Farm

United Pet. Company

Wildcat

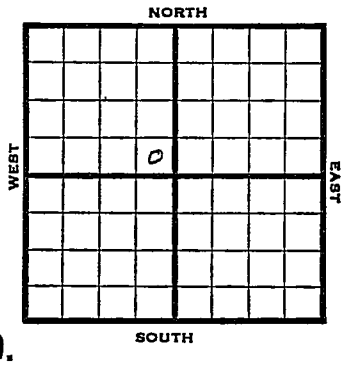

____ Ft. from N. Line

330 Ft. from S. Line

330 Ft. from E. Line

____ Ft. from W. Line

SE NW O.W.W.O.

1948 Elev. 1809' REPORT

4/7 8" @ 266'
Anhy. 600'
Drlg. 1548'

4/14 Lansing 3058'
Drlg. 3091'

4/21 Arbuckle 3343'
TD 3395'
ABANDONED

1950
7/12 O.W.W.O.
Lans 3058 Arb 3343
TD 3395
D&A

- - - - - -

Rigging Up
8/2 Lans 3058 Arb 3343
OTD 3395
DD 3410
perf Arb 500A S/30 bwph
Sq. off 6/3365-67 11/3363-67
16/3363-67 6/3354-57 500A
S/½ boph 1500A S/wtr PB 3159
9/3133-36 wtr 24/3117-21 750A
SSO SP 3108 18/3090-96
500 A, 200' water in hole
D&A

ABANDONED

Form 26—200 Bks.—1-48—Palace Kansas

Wildcat

Map No. _____ Sec. 8 Twp. 18 R. 11W


Well No. 1 Dalziel

United Pet. Company

FIRST REPORT Contractor

SE NW

SECTION PLAT

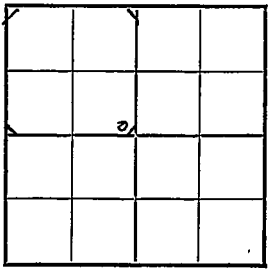

_____ Ft. from N. Line

330 Ft. from S. Line

330 Ft. from E. Line

_____ Ft. from W. Line

Barton County

Location _____

Rig up _____

Drilling and Remarks:

8" @ 266

Anhy 600

drlg. 1548

RECORD

Cased _____ in., _____ ft.

Sand _____

Gas _____

Oil _____

Total Depth _____

PRODUCTION

1st 24 hrs. Nat. _____

1st 24 hrs. after shot _____

Gas _____ Cu. Ft.

Dry Hole _____

Abandoned _____

Date

APR 7 1948 19

S. J. LEWIS Scout

Form 26—200 Bks.—1-48—Palace

Wildcat

Kansas

Map No. 55 Sec. 8 Twp. 18 R. 11W

Well No. 1 Dalziel


United Prod. Company

ABANDONED Contractor

SE NW

El. 1809

SECTION PLAT

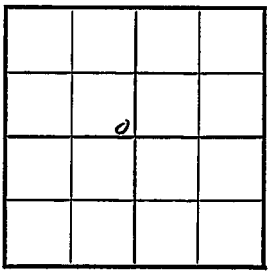

____ Ft. from N. Line

330 Ft. from S. Line

330 Ft. from E. Line

____ Ft. from W. Line

Barton County

Location

Rig up

Drilling and Remarks:

Cr Y3348

RECORD

Cased ____ in., ____ ft.

Sand

Gas

Oil

Total Depth 3385

PRODUCTION

1st 24 hrs. Nat.

1st 24 hrs. after shot

Gas ____ Cu. Ft.

Dry Hole

Abandoned

Date

APR 21 1948 19

S. J. LEWIS Scout

FORM 275 FOR SALE BY KANSAS BLUE PRINT CO.


County Barton State Kansas

Sec. 8 (Blk. Twp.) 18 (Sur. Rge.) 11W Map No.

Operator Henderson Oil

Well No. 1 Farm Dalziel

Elev. 1809 Location SE SE NW

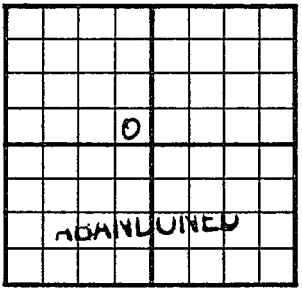

330 Ft. From S Line NW

330 Ft. From E Line Quarter

1st. Report

Completion AUG 2 1950

Remarks OWWO

Spudding Date

Drlg. Data

Lans. 3058 Arb. 3343 OTD 3395

DD 3410 Perf. Arb. 500 A S/ 30 bwph

Sq. off 6ø 3365-67 11/ 3363-67

16/ 3363-67 6/ 3354-57 500 A

S/ ½ boph 1500 A S/ water PB 3159

9/ 3133-36 water 24/ 3117-21 750 A

SSO SP 3108 18/ 3090-96 500 A

200' water in hole

D & A

J. E. TYRA

Form 26 200 Bks. 11-49 Petrol

Kansas

OWWO

Map No. ____ Sec. 8- Twp. 18 R. 11W

Well No. 1 Dalziel


Henderson Oil Company

Todd Contractor

SE SE NW

E 1. 1809

SECTION PLAT

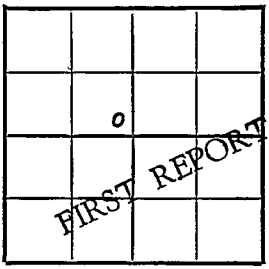

____ Ft. from N. Line

330 Ft. from S. Line

330 Ft. from E. Line

____ Ft. from W. Line

Barton County

Location

Rig up

Drilling and Remarks:

Lans. 3058
Arb. 3343
TD 3395
D & A

Rigging up

RECORD

Cased ____ in., ____ ft.

Sand

Gas

Oil

Total Depth

PRODUCTION

1st 24 hrs. Nat.

1st 24 hrs. after shot

Gas ____ Cu. Ft.

Dry Hole

Abandoned

Date

JUL 12 1950 19

J. E. TYRA Scout