Barton


FORM 51

KANSAS

Section 8 Township 18 Range 11W

Well No. #1 Jordan

Company Welch & Olsson Drlg.

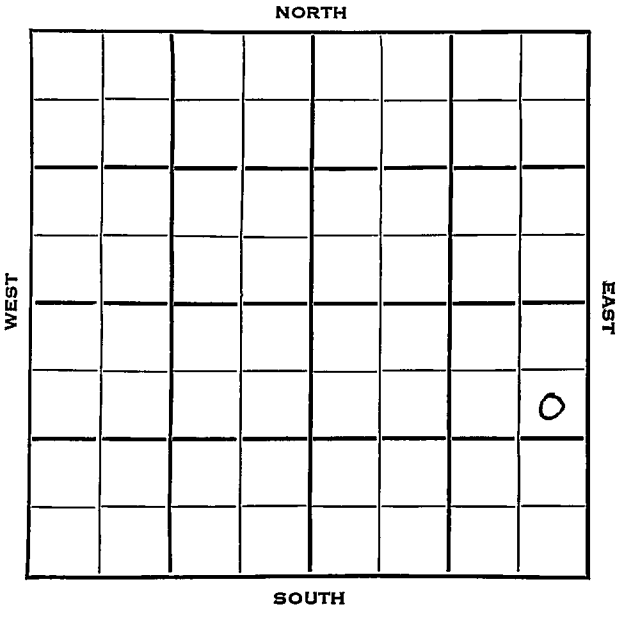

FORM 252-B
10M 10-50 PETROL

Barton

KANSAS

Sec. 8 Twp. 18 R. 11W

Well No. #1 Jordan Farm

Welch & Olsson Drlg. Company

Olsson Drlg. Contractor

NW Ames Pool


990 Ft. from N. Line

Ft. from S. Line

330 Ft. from E. Line

Ft. from W. Line

SE NE SE

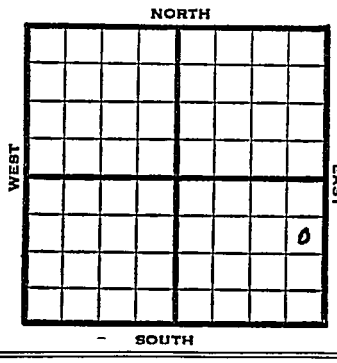

Elev. 1792'

1953	REPORT
4/29	Spud 4-27-53 8" @ 200' Drlg.
5/7	Anhy 628' Drlg 2901'
5/21	Heeb 2926 Br li 3036 Lans 3051 Arb. 3333' RTD 3337 5" @ 3331 CO 3337' 250 A No help 1100 A DD 3341' TD S/1/2 BOPH Sq.
5/27	Spud 4-27-53 D & A TD 3341' 8" @ 200' Anhy 628, Heeb 2926, Br. Lime 3036, Lans 3051, Arb 3333, TD 3337' 5" @ 3331' CO to 3337 250 A 1100 A DD 3341 S/ ½ boph CO to 3341 st-frac. 7 bo 72 bw 8 hr. D & A

ABANDONED

FORM 275 FOR SALE BY KANSAS BLUE PRINT CO


County Barton State Kansas

Sec. 8 (Blk. Twp.) 18 (Sur. Rge.) 11W Map No.

Operator Welch & Olsson Drlg.

Well No. 1 Farm Jordan

Elev. Location SE NE SE

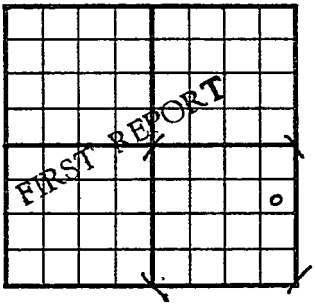

990 Ft. From N Line SE

330 Ft. From E Line Quarter

1st. Report APR 2 9 1953

Completion

Remarks

Olsson Drlg. - Contr.

Spudding Date 4-27-53

Drlg. Data NW Ames Pool

8" @ 200 drlg.

J. G. McGEHEE

FORM 275 FOR SALE BY KANSAS BLUE PRINT CO.


County Barton State Kansas

Sec. 8 (Blk. Twp.) 18 (Sur. Rge.) 11W Map No.

Operator Welch & Olsson Drlg.

Well No. 1 Farm Jordan

Elev. 1792 Location SE NE SE

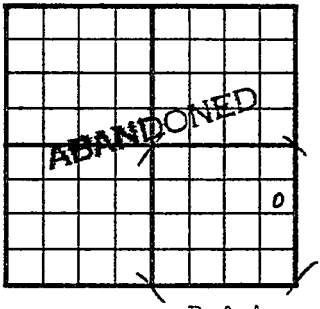

990 Ft. From N Line SE

330 Ft. From E Line Quarter

1st. Report

Completion MAY 27 1953

Remarks NW Ames Pool
Olsson Drlg. - Contr.

Spudding Date 4-27-53

Drlg. Data D & A TD 3341

8" @ 200 Anhy 628 Heeb. 2926

Br. lime 3036 Lans. 3051 Arb. 3333

TD 3337 5" @ 3331 CO to 3337

250 A 1100 A DD 3341 S/ ½ boph

CO to 3341 st-frac ..7 bo 72 bw 8 hr.

D & A

J. G. McGEHEE