

Barton

KANSAS

Section 9 Township 18 Range 13W

Well No. #1 Eveleigh

Company Herndon Drlg.

NORTH

			0				

WEST

EAST

SOUTH

Barton
18

KANSAS

Sec. 9 Twp. 18 R. 13W ✓

Well No. # 1 Eveleigh Farm

Herndon Drlg. Company

Wildcat Contractor


 Ft. from N. Line

330' Ft. from S. Line

330' Ft. from E. Line

 Ft. from W. Line

SE SE NW

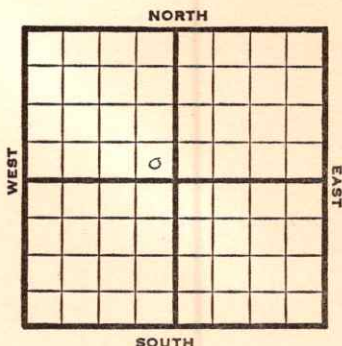

1950 **Elev. 1814'** REPORT

3/15 Spud 3-3-50
13" @ 89'
Anhy 750'
8" @ 765'
Lans 3084'
DST 3087-3118'

5/24 12 @ 89
Anhy 750
8" @ 765
Lans 3084
DST 3087-3118
rec mud
DST 3129-38
rec 15" ocm
Arb 3305-13
5" @ 3311
TD 3316
PB to KC
12/3078-82
15/3092-97
500 acid
1½ bopd
500 acid
½ bbl fluid phr 20% oil
12/3103-07
6/3122-24
18/3156-62
500 acid
comp 10 bopd 35 gr
Completed **COMPLETED**

Kansas

Wildcat

Map No. _____ Sec. 9 Twp. 18 R. 13WWell No. 1 EveleighHerndon Drlg._____
Company_____
Contractor

SE SE NW

El. 1814

SECTION PLAT

_____
Ft. from N. Line330 Ft. from S. Line330 Ft. from E. Line_____
Ft. from W. LineBarton County

Location _____

Rig up _____

Drilling and Remarks:

Spud 3-3-50

13" @ 89

Anhy 750

8" @ 765

Lans. 3084

DST 3087-3118

RECORD

Cased _____ in., _____ ft.

Sand _____

Gas _____

Oil _____

Total Depth _____

PRODUCTION

1st 24 hrs. Nat. _____

1st 24 hrs. after shot _____

Gas _____ Cu. Ft.

Dry Hole _____

Abandoned _____

Date

MAR 15 195019J. E. TYRAScout

Kansas

9

18

Map No. _____ Sec. _____ Twp. _____ R. 13W

Well No. 1 Eveleigh

Herndon Drlg.

Company

Contractor

SE SE NW


E1. 1814
SECTION PLAT

_____ Ft. from N. Line

330 _____ Ft. from S. Line

330 _____ Ft. from E. Line

_____ Ft. from W. Line

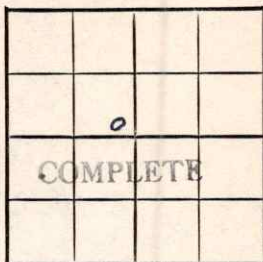

Barton

Location _____

Rig up _____

Drilling and Remarks:

13" c 89
 anky 750
 8" jc 765
 Lams. 3084
 DST 3087-3118
 Rec. mud.
 DST 3129-38
 Rec. 15" acm

RECORD

Cased _____ in., _____ ft.

Sand _____

Gas _____

Oil _____

Total Depth _____

PRODUCTION

1st 24 hrs. Nat. _____

1st 24 hrs. after shot _____

Gas _____ Cu. Ft.

Dry Hole _____

Abandoned _____

Date

MAY 24 1950

19

J. E. TYRA Scout

arb. 3305-13

5" c 3311

T.D. 3316

PB to K.C.

12/ 3078-82

15/ 3092-97

500 acid 1956

1½ bopd

500 acid

½ hbl. fluid phv.

12/ 3103-07

6/ 3122-24

18/ 3156-62

500 acid

comp. 10 bopd

35 gr.

Scout Cards
Land Small Map
Land Wall Map
Tracings
France Map
Pierce Map
Misc.

JUN 5
