

Barton

FORM 51

KANSAS

Section 10 Township 18 Range 13W

Well No. 1 - Proksch

Company Don Ingling et al

NORTH

0							

SOUTH

WEST

EAST

Barton


KANSAS ✓

Sec. 10 Twp. 18 R. 13WWell No. #1 Protsch FarmDon Ingling et al CompanyWildcat Contractor Ft. from N. Line330 Ft. from S. Line Ft. from E. Line330 Ft. from W. Line

SW SWNW

Stanolind Farmout &

\$2500 DHM

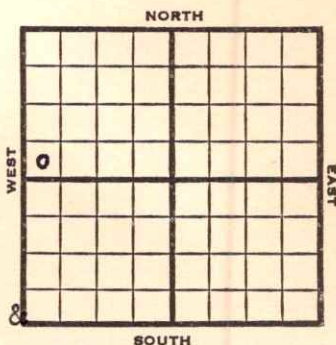

1952 Elev. 1810' REPORT

12/23 Spud 12-20-52
8" @ 760' WOC

12/25 WOC

1/1 Drlg. 2315

1/8 Top 2744 Heeb 2980 Dodge 2995 Br 1
3065 Lans 3080 DST 3116-36 35 mins
100' m & W #550 1240# Arb 3310
Drlg. 33571/14 Spud 12-20-52
D&A TD 3356
8" @ 760Top 2744, Heeb 2980, Dodge
2995, Br 1 line 3065, Lans 3080
DST 3116-36, opn 35 mins., rec.
100' mud & wtr. & SSO 1240#
Arb. 3310
TD 3356
D&A

ABANDONED

County Barton State KansasSec. 10 (Blk. 18) (Sur. 13W) Map No.Operator Don Ingling etal.Well No. 1 Farm ProksehElev. Location SW SW NW


10

FIRST REPORT

330 Ft. From S Line NW330 Ft. From W Line Quarter1st. Report DEC 23 1952

Completion

Remarks Stanolind farmout &\$2500 DHMSpudding Date 12-20-52Drlg. Data Wildcat8" @ 760 WOC

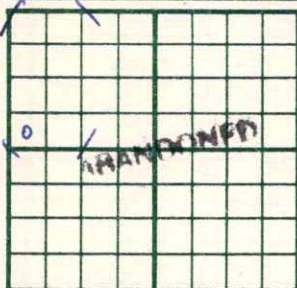County Barton State KansasSec. 10 (Blk.
Twp.) 18 (Sur.
Rge.) 13W Map No.Operator Don Ingling etal.Well No. 1 Farm ProkschElev. 1810 Location SW SW NW330 Ft. From S Line NW330 Ft. From W Line Quarter

1st. Report

Completion JAN 14 1953Remarks WildcatSpudding Date 12-20-52Drlg. Data D & A TD 33568" @ 760 Top. 2744 Heeb. 2980Dodge 2995 Br. line 3065 Lans. 3080DST 3116-36 open 35 min. Rec. 100' mud& wtr. & SSO 1240# Arb. 3310TD 3356D & A

J. G. McGEHEE