FORM 51 25M-3349 PETROLEUM


KANSAS

Barton

Section 9 Township 18S Range 11W.

Well No. #1 Hamilton

Company R. Williams et al

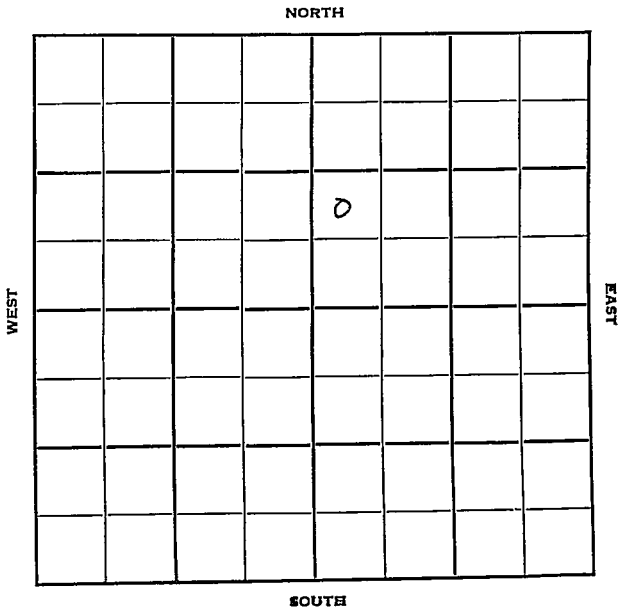

FORM 252-A
5M 10-48 PETROL

Barton

Sec. 9 Twp. 18 R. 11-W

Well No. #1 Hamilton Farm

R Williams etal Company

Cont— Harms & Knight

Ames


_____ Ft. from N. Line

990 Ft. from S. Line

_____ Ft. from E. Line

330 Ft. from W. Line

NW SW NE

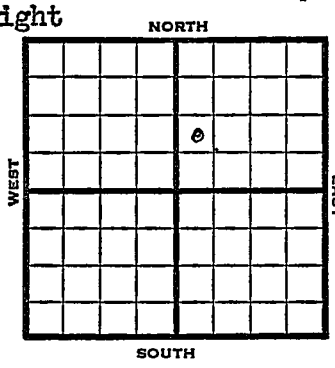

1949	Elev. 1776' REPORT
10/12	8"@ 246' Anhy 610 Drlg 1780'
10/19	TD 3330'
10/26	Lans 3030 Arb 3325' TD 3330' ABANDONED

Form 26 200 Bks. 6-49 Petrol

Kansas

Ames Pool

Map No. ____ Sec. 9 Twp. 18 R. 11W

Well No. 1 Hamilton


R. Williams etal. Company

Harms & Knight Contractor

NW SW NE

FIRST REPORT

SECTION PLAT

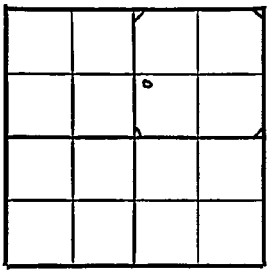

____ Ft. from N. Line

990 Ft. from S. Line

____ Ft. from E. Line

330 Ft. from W. Line

Barton County

Location ____

Rig up ____

Drilling and Remarks:

8" @ 246

Anhy 610

drlg. 1780

RECORD

Cased ____ in., ____ ft.

Sand ____

Gas ____

Oil ____

Total Depth ____

PRODUCTION

1st 24 hrs. Nat. ____

1st 24 hrs. after shot ____

Gas ____ Cu. Ft.

Dry Hole ____

Abandoned ____

Date

OCT 12 1949 19 S. J. LEWIS Scout

Form 26 200 Bks. 6-49 Petrol

Kansas

Ames Pool

Map No. ____ Sec. 9 Twp. 18 R. 11W

Well No. 1 Hamilton


R. Williams etal. Company

ABANDONED Contractor

NW SW NE

El. 1996.

SECTION PLAT

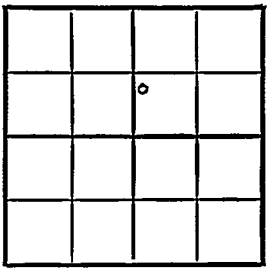

____ Ft. from N. Line

990 Ft. from S. Line

____ Ft. from E. Line

330 Ft. from W. Line

Barton County

Location ____

Rig up ____

Drilling and Remarks:

Lans 3230

Ck 3225.

RECORD

Cased ____ in., ____ ft.

Sand ____

Gas ____

Oil ____

Total Depth 3230

PRODUCTION

1st 24 hrs. Nat. ____

1st 24 hrs. after shot ____

Gas ____ Cu. Ft.

Dry Hole ____

Abandoned ____

Date

OCT 26 1949 19

S. J. LEWIS Scout