


Section 9 Township 18 S Range 11 W
Well No. # 1 Hamilton "B"
Company Imperial

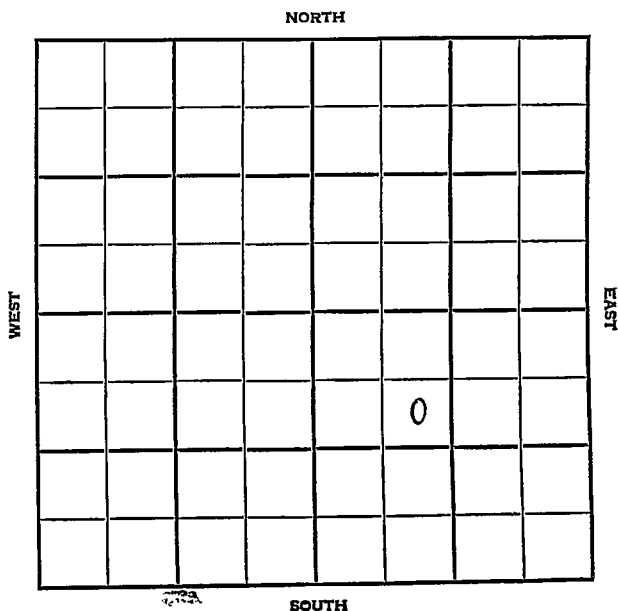

Barton KANSAS

SEC.	TWP.	R.
9	18S	11W

WELL NO.

1 Hamilton "B"

FARM

COMPANY

Imperial

CONTRACTOR

Prime Drlg. Tools


Ames NW

990 Ft. from N. Line

Ft. from S. Line

Ft. from E. Line

990 Ft. from W. Line

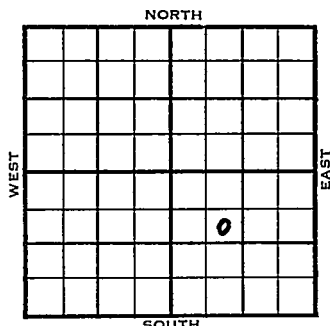

SE NW SE

	ELEVATION	REPORT
1954	1775'	

12/8 Spud 12-4-54
8" @ 241' w/275 sks
Drlg. 370'

1955
2/16


spud 12-4-54 - Oil Well
TD 3373'
8" @ 241'
Heeb. 2905', Br lime 3018', Lans. 3034'
DST 3098-3110', opn 1 hr., rec. 1400'
SW, 900#
DST 3195-3207', opn 40", rec. 10' mud,
760#
Cong. 3289'
DST 3312-18', opn 45", rec. 10' ocm,
950#
Arb. 3319'
DST 3320-25', opn 1 hr., rec. 730'
oil, 480' sul wtr, 1040#
TD 3373'
5" @ 3373'
CO to 3373'
29/3311-15, B/2 goph 300 M-A
S/3½ bo 27 bwp 7 hrs.
32/3315-18
B/2 goph 14/3318-19

(Information Brought Forward)

1955
2/16

B/15 goph
S 74 bo 4 bw 19 hrs.
Comp. 30 bopd 30 bw

COMPLETED

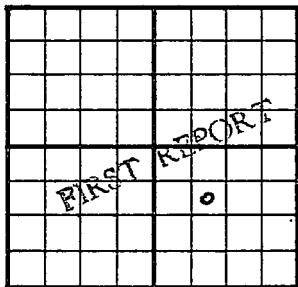
County Barton State KansasSec. 9 (Blk. Twp.) 18S (Sur. Rge.) 11W Map No.Operator ImperialWell No. 1 Farm Hamilton "B"Elev. Location SE NW SE990 Ft. From N Line990 Ft. From W Line SE Quarter1st. Report DEC. 8 1954

Completion

Remarks Prime Drlg toolsSpudding Date 12-1-54Drlg. Data Ames NW8" @ 241 w/275, Drlg 370

FABEN GILSTRAP

County Barton State Kansas
 Sec. 9 (Blk. 18) (Sur. 11W) Map No. 1
 Operator Imperial Drlg.
 Well No. 1 Farm Hamilton "B"
 Elev. 1775 Location SE NW SE

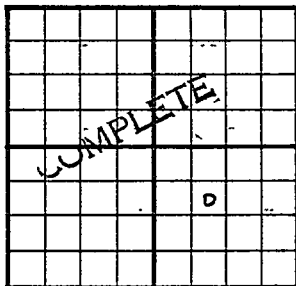

990 Ft. From N Line SE
990 Ft. From W Line Quarter
 1st. Report FEB 1 6 1955
 Completion Prime Drlg. - Contr.
 Remarks NW Ames Pool
 Spudding Date 12-4-54

Drlg. Data Oil well TD 3373
8" @ 241 Heeb. 2905 Br. lime 3018
Lans. 3034 DST 3098-3110 open 1 hr.
Rec. 1400' sw 900# DST 3195-3207
open 40 min. Rec. 10' mud 760#
Cong. 3289 DST 3312-18 open 45 min.
Rec. 10' ocm 950# Arb. 3319
DST 3320-25 open 1 hr. Rec. 730' oil
480' sul. wtr. 1040# TD 3373
5" @ 3373 CO to 3373 29/ 3311-15
B/ 2 goph 300 M-A S/ 3 1/2 bo 27 bwph
7 hr. 32/ 3315-18 B/ 2 goph 14/ 3318-
19 B/ 15 goph S/ 74 bo 4 bw 19 hr.
Comp. 30 bopd 30 bw

FABEN GILSTRAP