


Section 8 Township 18 Range 11WWell No. #1 JordonCompany Henderson Oil

NORTH

WEST

EAST

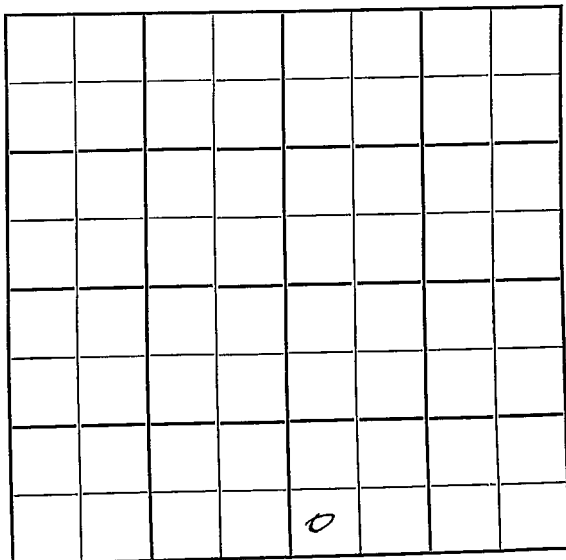

SOUTH

Barton

KANSAS

Sec. 8 Twp. 18 R. 11W ✓

Well No. #1 Jordon Farm

Henderson Oil Company

Contractor

Wildcat


Ft. from N. Line

330' Ft. from S. Line

Ft. from E. Line

330' Ft. from W. Line

SW SW SE

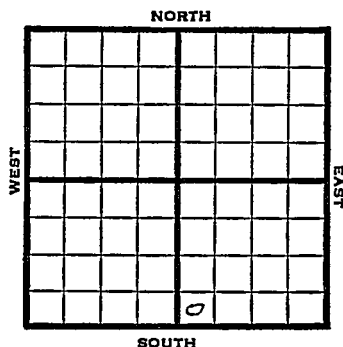

1950

Elev 1817

REPORT

3/29 Drlg.

5/10 TD 3381
8" @ 257
Topeka 2617
Hub 2958
Br L 3062
Lans 3081
Anb 3366
5" @ 3368
47 BOPD
17% wtr
Completed

COMPLETED

Map No. _____ Sec. 8 Twp. 18 R. 11WWell No. 1 Jordon

_____ Henderson Oil _____ Company

_____ Contractor


SW SW ⁴ E

SECTION PLAT

_____ Ft. from N. Line

330 _____ Ft. from S. Line

_____ Ft. from E. Line

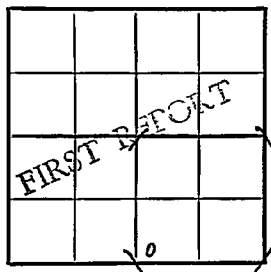330 _____ Ft. from W. Line

Barton County

Location _____

Rig up _____

Drilling and Remarks:

drlg.

RECORD

Cased _____ in., _____ ft.

Sand _____

Gas _____

Oil _____

Total Depth _____

PRODUCTION

1st 24 hrs. Nat. _____

1st 24 hrs. after shot _____

Gas _____ Cu. Ft.

Dry Hole _____

Abandoned _____

Date

MAR 29 1950

19

J. E. TYRA

Scout

Kansas

Map No. _____ Sec. 8 Twp. 18 R. 11WWell No. 1 Jordon

_____ Henderson Oil _____ Company

_____ Contractor


ST SW SE

EI. 1817
SECTION PLAT

_____ Ft. from N. Line

330 Ft. from S. Line

_____ Ft. from E. Line

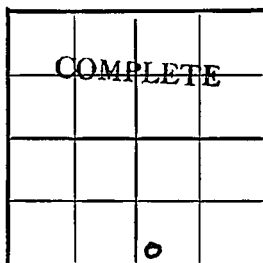330 Ft. from W. Line

Barton

Location _____

Rig up _____

Drilling and Remarks:

*8" @ 257**Topoka 2617**Hell 2958**Br L 3062**Sand 3081**Ant 3366**5" @ 3368*Date *MAY 10 1930*

RECORD

Cased _____ in., _____ ft.

Sand _____

Gas _____

Oil _____

Total Depth *3381*

PRODUCTION

1st 24 hrs. Nat. _____

1st 24 hrs. after shot _____

Gas *1* Cu. Ft.

Dry Hole _____

Abandoned _____

47 BOPD 17% water

J. E. TYRA

19

Scout