

KANSAS

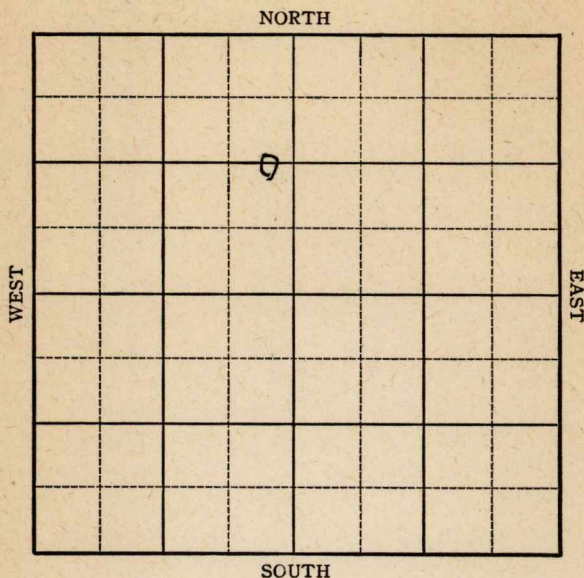
FORM 51 5M 11-44 PETROL

Butler County

Section 7 Township 27 Range 7E

Well No. #2 Eckel

Company H. H. Faulders



KANSAS

Butler County

Sec. 7 Twp. 27 R. 7E

Well No. #2 Eckel Farm

H. H. Faulders Company

Miscellaneous

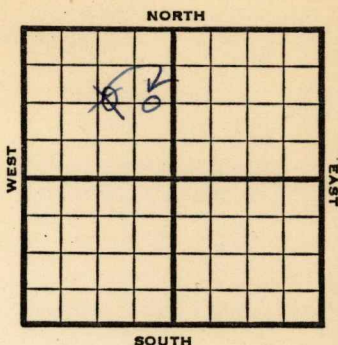
1300 Ft. from N. Line

330 Ft. from S. Line

1020 Ft. from E. Line

 Ft. from W. Line

CWL E/2 NW CEL NW



1946 Elev. 1433 REPORT

5/1	Machine
5/7	"
5/14	"
5/21	"
5/29	Spud
6/5	150' S.D.
6/12	"
6/18	"
6/26	"
7/3	12" @ 44' 500 SD
7/9	"
7/16	Drlg 520'
7/23	843 SD for csg.
7/30	10" @ 825 Drlg 925'
8/6	SD
8/13	1565, Run 8"
8/20	8" @ 928' 7" @ 1580' Drlg 2090'
8/27	5" @ 2199' Drlg 2222'
9/5	Lans 1883 KC 2193' 2219 SD

OVER

1946

9/10 Land 1883

KC 2193

221 9 SD

9/18 " "

9/24 " "

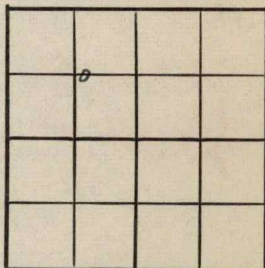
10/2 KC 2193'

TD 2231'

~~ABANDONED~~

KANSASKansas Pool Name MiscellaneousMap No. _____ Sec. 7 Twp. 27 R. 7EWell No. 2 EckelH. H. Faulders Company**FIRST REPORT**

Contractor

C W L E $\frac{1}{2}$ NW**SECTION PLAT**1300 Ft. from N. Line

_____ Ft. from S. Line

1020 Ft. from E. Line

_____ Ft. from W. Line

Butler County

Location _____

Rig up _____

Drilling and Remarks:

Machine

RECORD

Cased _____ in., _____ ft.

Sand _____

Gas _____

Oil _____

Total Depth _____

PRODUCTION

1st 24 hrs. Nat. _____

1st 24 hrs. after shot _____

Gas _____ Cu. Ft.

Dry Hole _____

Abandoned _____

Date

MAY 1 1946 19S. J. LEWIS Scout

KANSASKansas Pool Name MiscellaneousMap No. 10 Sec. 7 Twp. 27 R. 7EWell No. 2 Eckel

H. H. Faulders

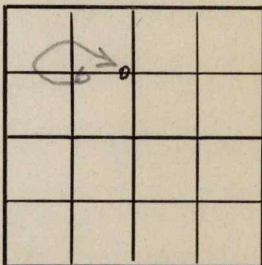
Company

CORRECTION

Contractor

C E L NW

SECTION PLAT

1300 Ft. from N. Line Ft. from S. Line330 Ft. from E. Line Ft. from W. Line

Butler County

Location Rig up

Drilling and Remarks:

Reported

C W L E $\frac{1}{2}$ NW

RECORD

Cased in., ft.Sand Gas Oil Total Depth

PRODUCTION

1st 24 hrs. Nat. 1st 24 hrs. after shot Gas Cu. Ft.Dry Hole Abandoned

Date

MAY 22 1946

19

S. J. LEWIS

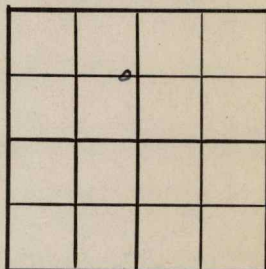
Scout

KANSASKansas Pool Name MiscellaneousMap No. 10 Sec. 7 Twp. 27 R. 7EWell No. 2 EckelH. H. Faulders

Company

ABANDONED

Contractor

- C E L NWE1, 1423
SECTION PLAT1300 Ft. from N. Line Ft. from S. Line300 Ft. from E. Line Ft. from W. LineButler CountyLocation Rig up

Drilling and Remarks:

MC 2193**RECORD**Cased in., ft.Sand Gas Oil Total Depth 2201**PRODUCTION**1st 24 hrs. Nat. 1st 24 hrs. after shot Gas Cu. Ft.Dry Hole Abandoned

Date

OCT 2 1946 19S. J. LEWIS

Scout