

Section 27 Township 20 Range 12W

Well No. #2 Churchill (B)

Company Alpine Oil & Roy. Co.

NORTH

0							

SOUTH

WEST

EAST

KANSAS

Barton

KANSAS

Sec. 27 Twp. 20 R. 12W

Well No. #2 Churchill "B" Farm

Alpine Oil & "oy. Co. Company

Quaker Drlg. Contractor

Bryan Pool


Ft. from N. Line

330 Ft. from S. Line

Ft. from E. Line

330 Ft. from W. Line

SW SW NW

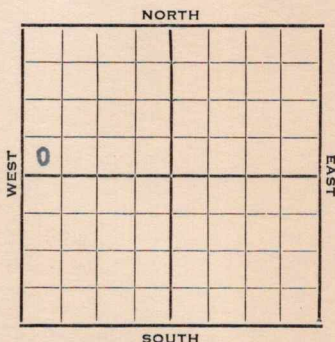

1953 Elev. 1834' REPORT

7/8 MIRT

7/22 10" @ 265
Anhy 610, Heeb 3021, Br li 3146, Lans 3163, Cong 3388, Arb. 3397

RTD 3412

7" @ 3411, CO

7/29 NR

8/5 NR

8/12 Spud 7-6-53

Oil Well

TD 3413'

10" @ 265'

Anhy 610, Heeb 3021, Br. Lime 3146, Lans 3163, Cong 3388, Arb 3397

TD 3412'

7" @ 3411'

CO to 3412

DD 3413 500 A S/ 2 boph

Comp. 25 bopd.

COMPLETED

County Barton

State Kansas

Sec. 27 (Blk.) 20 (Sur.) 12W Map No.

Operator Alpine Oil & Roy. Co.

Well No. 2 Farm Churchill (B)

Elev.	Location	SW	SW	NW
-------	----------	----	----	----

330 Ft. From S Line

330 Ft. From W Line Quarter

1st. Report JUL 8 1953

Completion

Remarks

Quaker Drlg. - Contr.

Spudding Date

Drlg. Data

Bryan pool

MIRT

J. G. McGEHEE

0

COMPLETE

1st. Report	
Completion	AUG 12 1953
Remarks	Bryan Pool
	Quaker Drlg. - Contr.
Spudding Date	7-6-53

[illegible]

J. G. McGEHEE