


Section 16 Township 18 Range 13W

Well No. 1 - Eveleigh

Company Dozier Oil

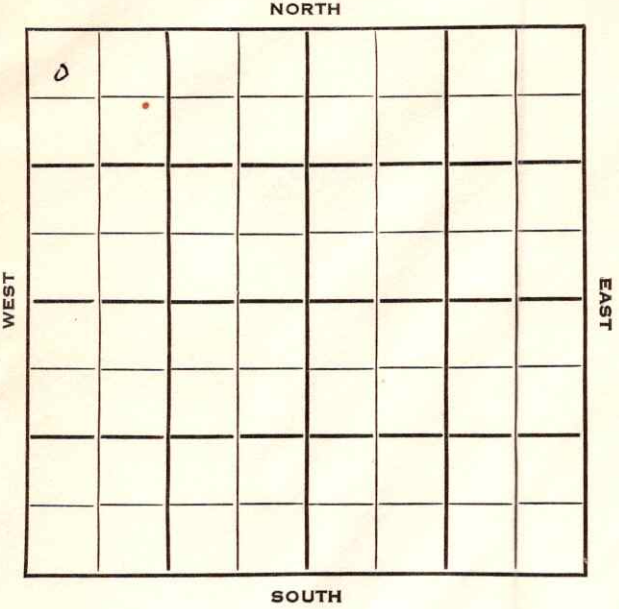

Barton

KANSAS ✓

Sec. 16 Twp. 18 R. 13W

Well No. #1 Eveleigh Farm

Dozier Oil Company

Stagg Drlg Contractor


330 Ft. from N. Line

\_\_\_\_\_ Ft. from S. Line

\_\_\_\_\_ Ft. from E. Line

330 Ft. from W. Line

NW NW NW  
Sunray Farmout

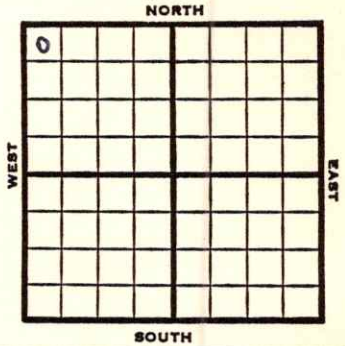

1953 **Elev. 1811'** REPORT

1/14 Spud 1-7-53  
8" @ 740  
**Anhy 736**  
Drlg. 2140'

1/23 Spud 1-7-53  
D&A  
TD 3335  
8" @ 740  
**Anhy 736, Heeb 2974, Tor 2986,**  
**Br. lime 3057, Lans 3069,**  
DST 3072-84, opn 1/2 hrs., rec.  
15' mud 0#  
**Cong 3301, Arb. 3319**  
DST 3323-35, opn 1 hr., rec.  
50' wtr., 240#  
D&A

**ABANDONED**

County Barton State KansasSec. 16 (Blk. Twp.) 18 (Sur. Rge.) 13W Map No.Operator Dozier OilWell No. 1 Farm EveleighElev. Location NW NW NW

0					

330 Ft. From N Line NW330 Ft. From W Line Quarter1st. Report JAN 14 1953

Completion

Remarks Sunray farmoutStagg D<sub>r</sub>lg. - Contr.Spudding Date 1-7-53

Drlg. Data

8" @ 740 Any 736 drlg. 2140

County Barton State Kansas

Sec. 16 (Blk. 18 (Sur. 13W Map No. 18) (Twp.) (Rge.)

Operator Dozier Oil

Well No. 1 Farm Eveleigh

Elev. 1811 Location NW NW NW

0				

330 Ft. From N Line NW

330 Ft. From W Line Quarter

1st. Report

Completion JAN 23 1953

Remarks

Stagg Drlg. - Contr.

Spudding Date 1-7-53

Drlg. Data D & A TD 3335

8" @ 740 Anhy 736 Heeb. 2974

Tor. 2986 Br. lime 3057 Lans. 3069

DST 3072-84 open 1/2 hr. Rec. 15' mud

0# Cong. 3301 Arb. 3319 DST 3323-35

open 1 hr. Rec. 50' wtr. 240#

D & A

