

Map No. 10 Sec. 10 Twp. 26 R. 7
Well No. 15 Schaar Farm
Cromwell & Lewis Company

WEST

EAST

SOUTH

Drilling Remarks

Drilling Remarks

Cased _____ in. _____ ft.

Sand-----

Gas _____

Oil_____

Total Depth.....

1st 24 hrs. Nat.-----

1st 24 hrs. after shot-----

Gas _____ cu. ft. _____

Dry Hole-----


Abandoned-----

Sedgwick

Map No. Sec. 10 Twp. 26 R. 2E

Well No. 1- Schaar Farm
Cromwell & Lewis Company

 Ft. from N. Line
330 Ft. from S. Line
 Ft. from E. Line
990 Ft. from W. Line

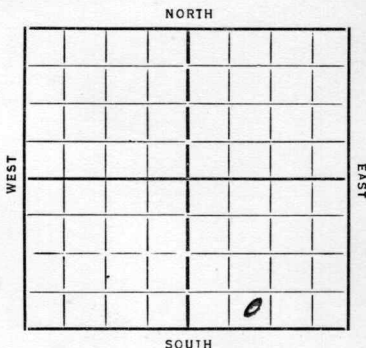

REPORT

Date 1935
4/24 Bldg.
5/2 Bldg.
5/9 —
5/16 Rig
5/23 —
5/29 Spud 57.
6/6 — 6/13 —
6/20 12" 110
6/28 dly 1460
7/3 " 1795
7/11 " 2725
7/18 8" 2889 TC 2420
TC 2917 T2 2918
Bailing fluid
8/8 HFW 2980 dly 3140
8/15 7" 3161 TV 3203
T2 3206 215 Oil 210 W.
8/21 Chst 2917
Viola 3203
T2 3206
215 Oil 210 Wtc 1000 acid
JFA.

ABANDONED

Form 26—1M Bks. 9-28

Map No. 13 Sec. 10 Twp. 26 R. 2EWell No. 1 - SchaarCromwell + Lewis Company

Contractor

FIRST REPORT

SECTION PLAT

Ft. from N. Line

330 Ft. from S. Line

Ft. from E. Line

990 Ft. from W. Line

Location

Rig up

Drilling and Remarks:

Bedg

RECORD

Cased _____ in., _____ ft.

Sand _____

Gas _____

Oil _____

Total Depth _____

PRODUCTION

1st 24 hrs. Nat. _____

1st 24 hrs. after shot _____

Gas _____ Cu. Ft.

Dry Hole _____

Abandoned _____

Date

4-27-35 192

ORVAL MANNSCHRECK Scout

Map No. 13 Sec. 10 Twp. 26 R. 2 EWell No. 1- SchaarCromwell + Lewis Company

Contractor

ABANDONED

SECTION PLAT

Ft. from N. Line

330 Ft. from S. Line

Ft. from E. Line

990 Ft. from W. Line

Location

Rig up

Drilling and Remarks:

215 oil
210 water
1000 acid

OT #

RECORD

Cased _____ in., _____ ft.

Sand Chat 2917Gas Viola 3203

Oil _____

Total Depth 3206

PRODUCTION

1st 24 hrs. Nat. _____

1st 24 hrs. after shot _____

Gas _____ Cu. Ft.

Dry Hole _____

Abandoned _____

Date

8-21-35

192

ORVAL MANNSCHRECK

Scout