


Section 17 Township 18 Range 13W

Well No. #2 Cornelia

Company Shields Oil Producers

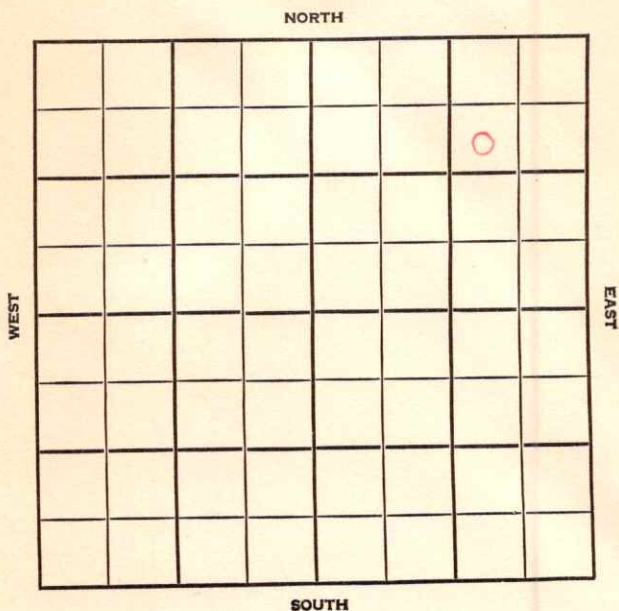

Barton

KANSAS

SEC.	TWP.	R.
17	18	13W

WELL NO.

2 Cornelius

FARM

COMPANY

Shields Oil Producers

CONTRACTOR


990' Ft. from N. Line

Ft. from S. Line

990' Ft. from E. Line

Ft. from W. Line

SW NE NE

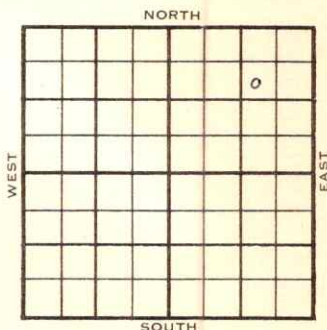

1955

ELEVATION

1813' RB

REPORT

6/1

Spud 5-29-55
8" @ 740

9-7

DST 3102-50 open 1 hr., rec 800' sw
BHP 1280# FP 0-480
DST 3190-3207 open 20", rec. 8' mud
BHP 0
DST 3213-85, open 1/2 hr., rec. 12' mud
BHP 0
DST 3292-3306, open 1 hr. rec 100' hocm
BHP 375#
5 1/2" 3303 w/50
FU 110' oil in 12 hrs., 1000 acid
2000 acid, Swb 2 1/2 bfph 40% oil POP
P 16 bopd plus 5 bwpd

<u>TOPS</u>	<u>DEPTH</u>
Anh.	729
H.	2969
Tr.	2979
B.L.	3051
L.	3064
C.	3298
A	3302

T.D. 3306'

COMPLETED

County Barton Elev. 1813 RB
 Sec. 17 Twp. 18 Rge. 13W
 Company Shields Oil Producers
 FarmName Cornelius No. 2

TOPS	DEPTH	LOG	DATUM	Loc. in Sec.
Anh.	<u>729</u>			SW NE NE
TP.				
H.	<u>2969</u>		<u>1156</u>	
Tr.	<u>2979</u>		<u>1166</u>	
Dg.				
Bl.	<u>3051</u>		<u>1238</u>	
L.	<u>3064</u>		<u>1251</u>	Geol.
K.C.				
B.K.C.				Contr.
Ce.				
C.	<u>3298</u>		<u>1485</u>	
M.				
M.				Pool
K.				
Mz.				
Me.				
V.				
S.				
A.	<u>3302</u>		<u>1489</u>	COMPLETE
R.				
PE.				
G.				
T.D.	<u>3306</u>			

Date Comm. 5/29/55 SEP 7 1955
 8" 740 DST 3102-50 open 1 hr Rec. 800'
 sw BHP 1280# FP 0-480 DST 3190-3207 open
 20" Rec. 8' mud BHP 0 DST 3213-85 open
 1/2 hr Rec. 12' mud BHP 0 DST 3292-3306 open
 1 hr Rec. 100' hocm BHP 375# 5 1/2" 3303 w/50
 FU 110' oil in 12 hrs. 1000acid 2000 acid
 Swb 2 1/2 bfph 40% oil POP
 P 16 bopd plus 5 bwpd