
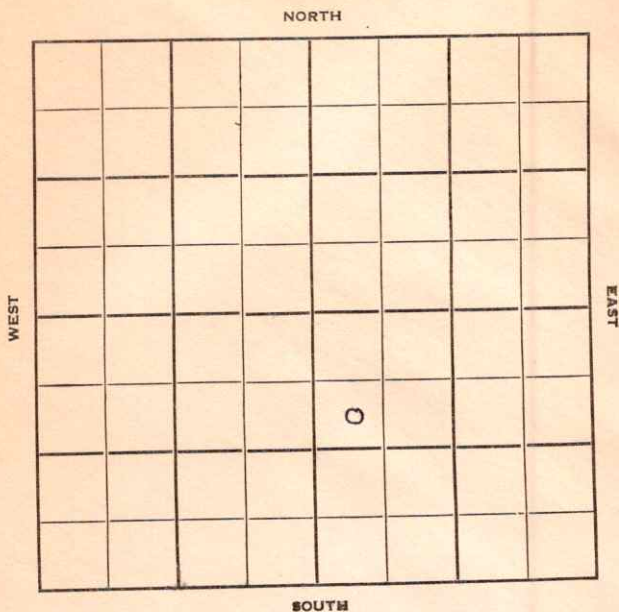


Section 17 Township 18 Range 13WWell No. #1 YeakleyCompany Lee Phillips

Sec. 17 Twp. 18 R. 13WWell No. #1 Yeakley FarmLee Phillips CompanyAsh-Mur. Contractor
Wildcat990 Ft. from N. Line Ft. from S. Line Ft. from E. Line330 Ft. from W. Line

SW NW SE

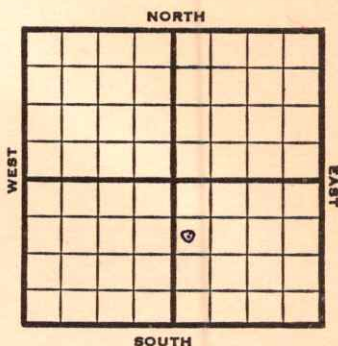

1952

Elev. 1820'

REPORT

11/12 RUR

11/20 Drlg. 2600'

11/26 Spud 11-11-52

D & A TD 3350' 8" @ 426

Anhy 745' Heeb 2988' Br. 11 3069'

Lans. 3082' Arb. 3317'

DST 3317-22 open 1 hr. rec 6' mud

TD 3350' D & A

ABANDONED

County **Barton** State **Kansas**Sec. **17** (Blk.) **18** (Sur.) **13W** Map No.Operator **Lee Phillips**Well No. **1** Farm **Yeakley**Elev. Location **SW NW SE**

FIRST REPORT

990 Ft. From **N** Line **SE**330 Ft. From **W** Line Quarter1st. Report **NOV 12 1952**

Completion

Remarks

Ash-Mur - Contr.

Spudding Date

Drlg. Data

Wildcat**RUR**

J. G. McGEHEE

County Barton State KansasSec. 17 (Blk. 18) (Sur. 13W) Map No. 18Operator Lee PhillipsWell No. 1 Farm YeakleyElev. 1820 Location SW NW SE990 Ft. From N Line SE330 Ft. From W Line Quarter

1st. Report

Completion NOV 26 1952Remarks WildcatAsh-Mur - Contr.Spudding Date 11-11-52Drlg. Data D & A TD 33508" @ 426 Anhy 745 Heeb. 2988Br. lime 3069 Lans. 3082 Arb. 3317DST 3317-22 open 1 hr. Rec. 6' mudTD 3350D & A

J. G. McGEHEE