

Bullet

Form 51—5M—11-31—Palace

Map No. _____ Sec. 7 Twp. 27 R. 7 E

Well No. 1 Seward Farm _____
National Refg Co. Company _____

NORTH

WEST	0							
								EAST

SOUTH

Location _____
Drilling Remarks _____

Rig Up _____
Drilling Remarks _____

RECORD

Cased _____ in. _____ ft.
Sand _____
Gas _____
Oil _____
Total Depth _____

PRODUCTION

1st 24 hrs. Nat. _____
1st 24 hrs. after shot _____
Gas _____ cu. ft.
Dry Hole _____
Abandoned _____

Butler

Map No. KANSAS Sec. 7 Twp. 27 R. 7 ^E

Well No. 1 Seward Farm


Natl Ref Co. Company

250' Ft. from N. Line

_____ Ft. from S. Line

_____ Ft. from E. Line

250' Ft. from W. Line

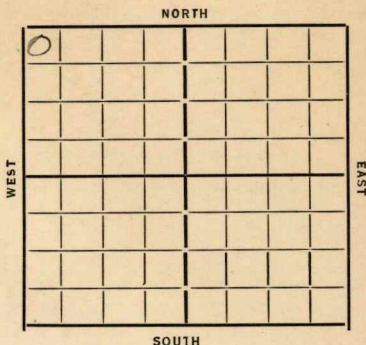

Date 1/23

REPORT

12/20 hlg 855'

12/27 " 1355

1/4 10" 922 - 8" 1607

1/11 R.C.L. 2085-2248

hreg 2260

1934

1/17 Sand 2265-73

T.D. 2279

D. + A. 2279

ABANDONED

Map No. 10 Sec. 7 Twp. 29 R. 7E

Well No. 1- Leonard

Nat'l Ref. Co Company

Contractor

FIRST REPORTS

250 Ft. from N. Line

..... Ft. from S. Line

..... Ft. from E. Line

250 Ft. from W. Line

SECTION PLAT

0			

Location.....

Rig up.....

Drilling and Remarks:

Qty 855

RECORD

Cased.....in.,ft.

Sand.....

Gas.....

Oil.....

Total Depth.....

PRODUCTION

1st 24 hrs. Nat.....

1st 24 hrs. after shot.....

Gas.....Cu. Ft.

Dry Hole.....

Abandoned.....

Date

12-20-33 192 O. Mannschick Scout

Map No. 10 Sec. 7 Twp. 27 R. 7 E

Well No. 1- Neward

Nat'l Ref Co Company

Contractor

SECTION PLAT

250 Ft. from N. Line

..... Ft. from S. Line

..... Ft. from E. Line

250 Ft. from W. Line

0			

Location.....

Rig up.....

Drilling and Remarks:

RECORD

Cased..... in., ft.

Sand 2265-73

Gas.....

Oil.....

Total Depth 2279

PRODUCTION

1st 24 hrs. Nat.....

1st 24 hrs. after shot.....

Gas..... Cu. Ft.

Dry Hole.....

Abandoned.....

Date

1-17-34 192 O. Mammuch Scout