


Section 17 Township 18 Range 13W
 Well No. #1 Yeakley
 Company Sohio etal.

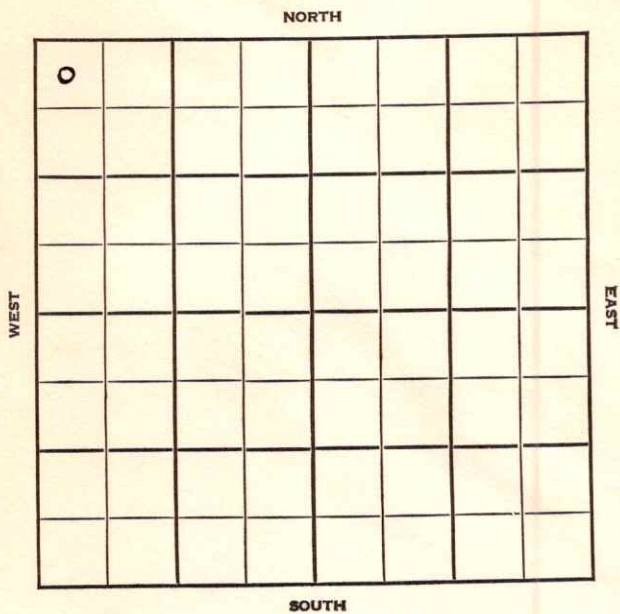

KANSAS

Barton

Sec. 17 Twp. 18 R. 13W

Well No. #1 Yeakley Farm

Sohio et al Company

Wildcat


330' Ft. from N. Line

Ft. from S. Line

Ft. from E. Line

330' Ft. from W. Line

NW/C

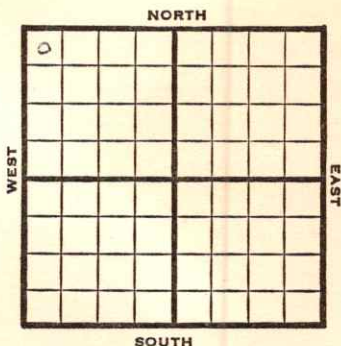

1948

Eli 1836'

REPORT

5/19 Location

5/26 "

6/1 8" @ 961'
Drilg. 1985'6/9 Lansing 3087'
Arbuckle 3317-23
TD 3323'
5"@ 3318'
RUST6/16 TD 3324'
500 acid swb 4 bbls oil PH 6 hrs.6/23 TD 3325'
swb 3½ bbls oil PH 14 hrs.

6/29 "

7/8 "

7/14 "

8/21 "

8/28 Arb. 3317'

5"@ 3318'

TD 3325'

500 acid

Pump 99 oil Pot

38° Gr.

Comp

COMPLETED

Map No. _____ Sec. 17 Twp. 18 R. 13W

Well No. 1 Yeakley

Sohio etal. Company

FIRST REPORT Contractor

NW/C


SECTION PLAT

330 Ft. from N. Line

_____ Ft. from S. Line

_____ Ft. from E. Line

330 Ft. from W. Line

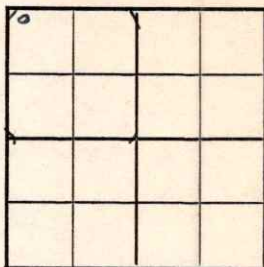

Barton County

Location X

Rig up _____

Drilling and Remarks:

RECORD

Cased _____ in., _____ ft.

Sand _____

Gas _____

Oil _____

Total Depth _____

PRODUCTION

1st 24 hrs. Nat. _____

1st 24 hrs. after shot _____

Gas _____ Cu. Ft.

Dry Hole _____

Abandoned _____

Date

MAY 19 1948 19

S. J. LEWIS Scout

Barton County Kansas State

Map No. 73 Sec. 17 Twp. 18 R. 13W

Well No. 1 Yeakley

Sohio etal. Company

COMPLETE

Contractor

NW/C

E 1/8

SECTION PLAT

0							

330 Ft. from N. Line

 Ft. from S. Line

 Ft. from E. Line

330 Ft. from W. Line

Yeakley Pool

Remarks:

Cur 3317

5" @ 3318'

7123325'

500000'

Pump 99 oil 104

08-54

Date

JUL 28 1948

Scout

S. J. LEWIS