
FORM 51

Barton KANSAS

Section 17 Township 18 Range 13 W

Well No. # 1 Yeakley

Company Shields Oil Producers

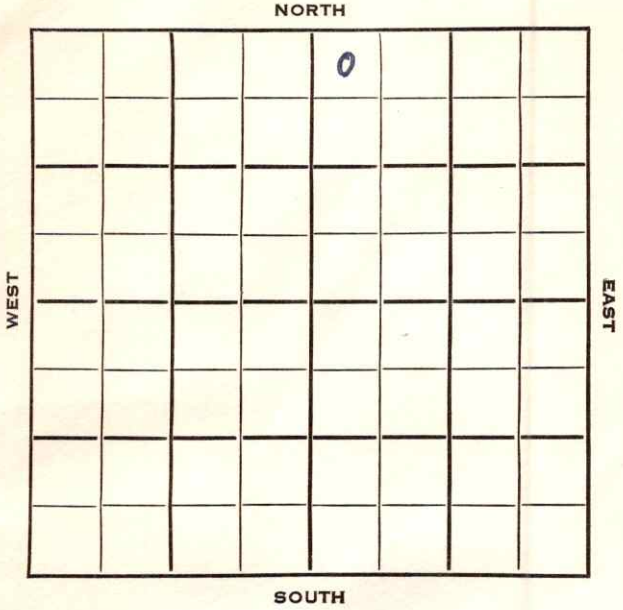

Barton KANSAS

SEC.	TWP.	R.
17	18	13W

WELL NO. 1 Yeakley FARM

COMPANY Shields Oil Producers

CONTRACTOR Mast Drlg.


Boyd Pool

330 Ft. from N. Line

Ft. from S. Line

Ft. from E. Line

330 Ft. from W. Line

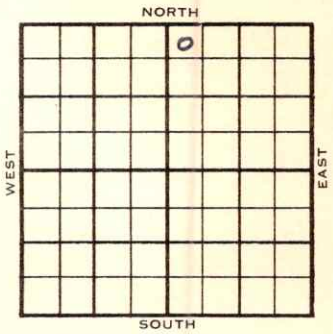

NW NW NE
Sohio DHM

1953 ELEVATION 1817' REPORT

10/21 Spud 10-14-53
8" @ 678'
Anhy 743'
Drlg. 2360'

10/28 Spud 10-14-53 D & A TD 3332'
8" @ 678 Anhy 743 Heeb 2976
Br lime 3055 Lans 3071
DST 3143-65 open ½ hr rec 12' mud
950# Cong. 3300 Arb. 3312
DST 3313-18 open ½ hr rec 6' mud 90#
DST 3320-32 open 2 hr rec 1365' sul.
wtr. 950# TD 3332' D & A

ABANDONED

DX-78

FORM 275 FOR SALE BY KANSAS BLUE PRINT CO.


County Barton State Kansas

Sec. 17 (Blk. Twp.) 18 (Sur. Rge.) 13W Map No.

Operator Shields Oil Producers

Well No. 1 Farm Yeakley

Elev. 1817 Location NW NW NE

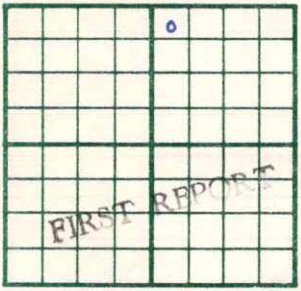

330 Ft. From N Line NE

330 Ft. From W Line Quarter

1st. Report OCT 21 1953

Completion

Remarks Sohio - DHM
Mast Drlg. - Contr.

Spudding Date 10-14-53

Drlg. Data Boyd Pool

8" @ 678 Anhy 743 drlg. 2360

J. G. McGEHEE

FORM 275 FOR SALE BY KANSAS BLUE PRINT CO.

County Barton State Kansas

Sec. 17 (Blk. Twp.) 18 (Sur. Rge.) 13W Map No.

Operator Shields Oil Producers

Well No. 1 Farm Yeakley

Elev. 1817 Location NW NW NE



330 Ft. From N Line NE

330 Ft. From W Line Quarter

1st. Report

Completion OCT 28 1953

Remarks Boyd Pool
Mast Drlg. - Contr.

Spudding Date 10-14-53

Drlg. Data D & A TD 3332

8" @ 678 Anhy 743 Heeb. 2976

Br. lime 3055 Lans. 3071 DST 3143-65

open ½ hr. Rec. 12' mud 950#

Cong. 3300 Arb. 3312 DST 3313-18

open ½ hr. Rec. 6' mud 90#

DST 3320-32 open 2 hr. Rec. 1365' sul.
wtr. 950# TD 3332

D & A

J. G. McGEHEE