


Sedgwick

Form 51-5M-11-31-Palace

Map No. **KANSAS** Sec. *11* Twp. *26* R. *2 E*

Well No. *2* *Erdwein* Farm
Alyward & Shell Company

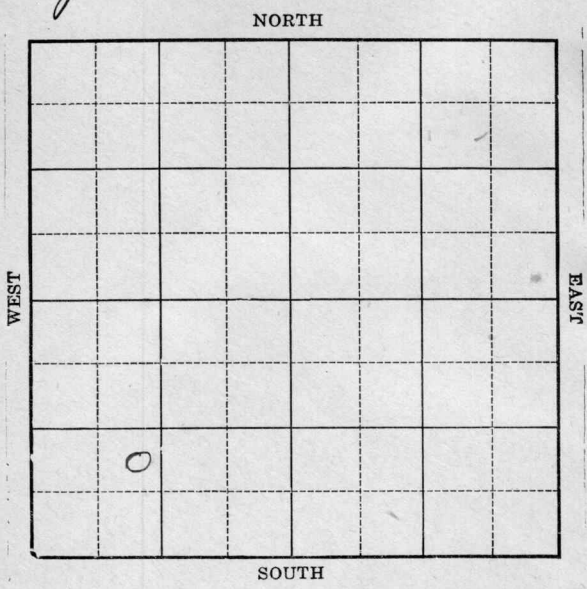

Location _____
Drilling Remarks _____

Rig Up _____
Drilling Remarks _____

RECORD

Cased _____ in. _____ ft.
Sand _____
Gas _____
Oil _____
Total Depth _____

PRODUCTION

1st 24 hrs. Nat. _____
1st 24 hrs. after shot _____
Gas _____ cu. ft.
Dry Hole _____
Abandoned _____

Sedgwick

Map No. *KANSAS* Sec. *11* Twp *26* R. *2E*

Well No. *2 Edwin* Farm


Alyward & Shell Company

_____ Ft. from N. Line

973 Ft. from S. Line

_____ Ft. from E. Line

945 Ft. from W. Line

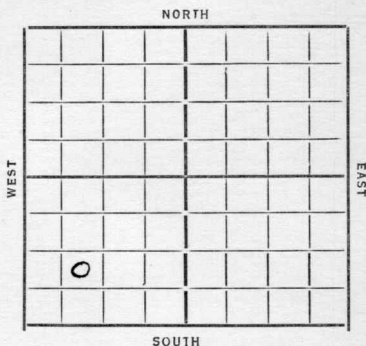

Date *1934*

REPORT

2/28 Bldg Rig
3/8 Rign up
3/15 Drlg 1010
3/22 " 1940 10" at 1402
3/29 Chat 2855 S.O. 2855-57
6" 2857 Drlg 2871
4/5 Dlg 3074
4/12 B.L. 3118 TV 3170 350 oil
350 w. acidizing
4/19 —
4/25 Viola 3170 TD 3172 1000
Hal acid 323 oil 900 water

COMPLETED

Map No. 13 Sec. 11 Twp. 26 R. 2EWell No. 2 - Erdwein
Alyward & Shell Company

Contractor

SECTION PLAT

0			

Ft. from N. Line

973 Ft. from S. Line

Ft. from E. Line

945 Ft. from W. Line

FIRST REPORTS

Location.....

Rig up.....

Drilling and Remarks:

BR

RECORD

Cased.....in., ...ft.

Sand.....

Gas.....

Oil.....

Total Depth.....

PRODUCTION

1st 24 hrs. Nat.....

1st 24 hrs. after shot.....

Gas.....Cu. Ft.

Dry Hole.....

Abandoned.....

Date

2-28-34 O. W. Mammuch Scout

KANSAS

Map No. 13 Sec. 11 Twp. 26 R. 2 EWell No. 2 - ErdweinAlyward et al Company

Contractor

COMPLETED**SECTION PLAT**

0			

 Ft. from N. Line973 Ft. from S. Line Ft. from E. Line945 Ft. from W. LineLocation Rig up

Drilling and Remarks:

1000 gal acid323 oil
900 water**RECORD**Cased in., ft.Sand Viola 3170Gas Oil Total Depth 3172**PRODUCTION**1st 24 hrs. Nat. 1st 24 hrs. after shot Gas Cu. Ft.Dry Hole Abandoned

Date

4-25-34 19

ORVAL MANNSCHRECK

Scout