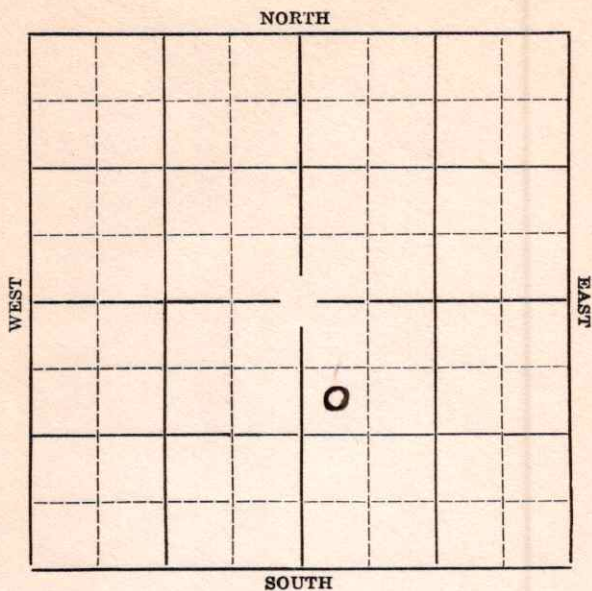
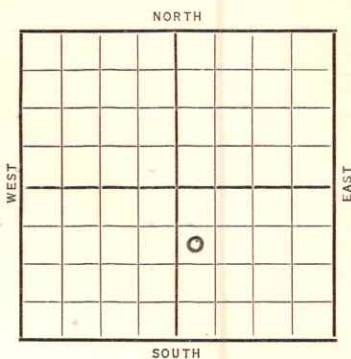


Section 18 Township 20 Range 9-WWell Number 3 ProffittCompany Ohio Oil

Sec. 18 Twp. 20 R. 9-WWell No. #3 Proffitt FarmOhio Oil Company990 Ft. from N. Line Ft. from S. Line Ft. from E. Line330 Ft. from W. Line

Elev. 1803

Date
1937

REPORT

3/3 Location

3/11 ROG

3/18 Rig

3/25 Spud.

4/2 20" @ 122', 15" @ 635' Drlg.
1315'4/8 12" @ 1735', 10" @ 2006'
Drlg. 2100'

4/16 10" underream 2330'.

4/23 10" @ 2320'. Drlg. 2685'.

4/30 8" @ 2815'. K.C. 3015'.
Rng. 6" @ 3095'.5/7 Sil. 3327'. T.D. 3331'.
200' oil 1 hr.
Cementing pipe.

OVER

1937

5/12 6" @ 3327'.

Sil. 3327'.

T.D. 3333 $\frac{1}{2}$ '.

Pot. 1130 bbls. 24 hrs.

Natural.

COMPLETED

KANSAS

Map No. 49 Sec. 18 Twp. 20 R. 9WWell No. 3 ProffittOhio Oil Company

Contractor

SECTION PLAT

		0	

990 Ft. from N. Line

_____ Ft. from S. Line

_____ Ft. from E. Line

330 Ft. from W. Line

FIRST REPORT

Location ✓

Rig up _____

Drilling and Remarks:

RECORD

Cased _____ in., _____ ft.

Sand _____

Gas _____

Oil _____

Total Depth _____

PRODUCTION

1st 24 hrs. Nat. _____

1st 24 hrs. after shot _____

Gas _____ Cu. Ft.

Dry Hole _____

Abandoned _____

Date

MAR 3 1937

S. J. LEWIS Scout

KANSAS

Map No. 49 Sec. 18 Twp. 20 R. 9WWell No. 3-ProffittOhio Company

Contractor

COMPLETED

SECTION PLAT

990 Ft. from N. Line

_____ Ft. from S. Line

_____ Ft. from E. Line

330 Ft. from W. Line

Location _____

Rig up _____

Drilling and Remarks:

Pot. 1130/24 hrs

Nat

RECORD

Cased 6 in., 3327 ft.Sand 511 - 3327

Gas _____

Oil _____

Total Depth 3333 1/2

PRODUCTION

1st 24 hrs. Nat. _____

1st 24 hrs. after shot _____

Gas _____ Cu. Ft.

Dry Hole _____

Abandoned _____

Date

H. D. Hatfield

MAY 12 1937 19

Scout